


10182-S2-PL-ENG-DWG-21420
DRAWING NUMBER

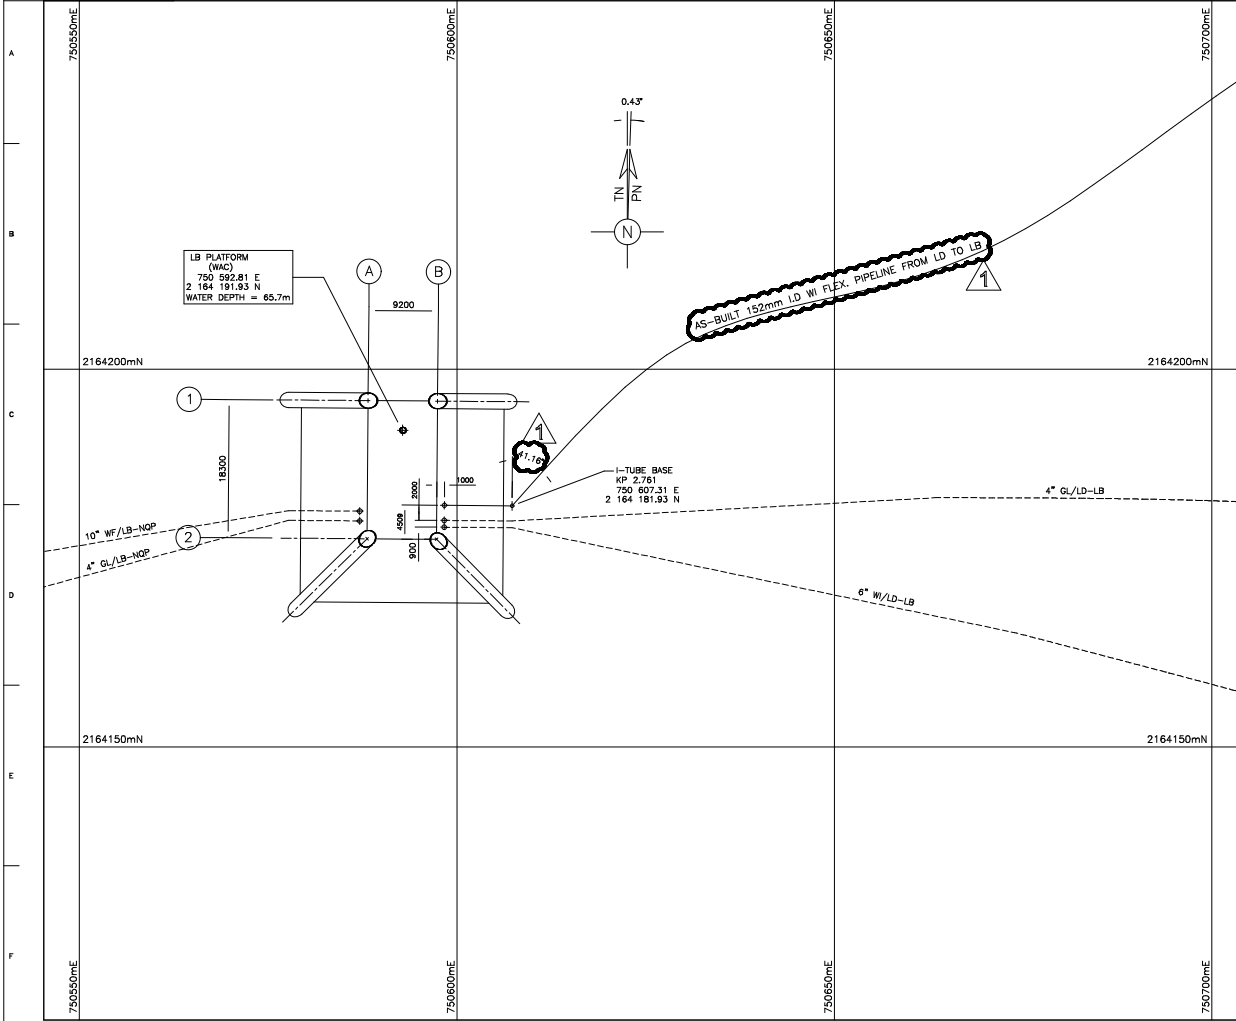

THIS DRAWING MUST NOT BE USED FOR CONSTRUCTION UNTIL SPECIFICALLY CERTIFIED FOR THAT PURPOSE UNDER AN ISSUE.

NOTES

1. ALL DIMENSIONS ARE IN MILLIMETRES AND COORDINATES ARE IN METRES.
2. ALL COORDINATES ARE BASED ON UNIVERSAL TRANSVERSE MERCATOR PROJECTION ON EVEREST 1830 SPHEROID, ZONE 42 CENTRAL MERIDIAN 66° EAST ON BOMBAY HIGH DATUM.
3. THE PIPELINE BEARINGS ARE WITH REFERENCE TO TRUE NORTH.
4. THE LOCATION OF THE EXISTING PLATFORMS AND PIPELINES ARE BASED ON THE PRE-ENGINEERING SURVEY DRAWINGS BY FLUORO SUDLEY INDIA PVT. LTD.

1

AS-BUILT

LEGEND

- AS-BUILT 1-TUBE AND FLEX PIPELINE
- AS-BUILT RISER AND DEPARTURE
- EXISTING PIPELINE
- TN - TRUE NORTH
- PN - PLATFORM NORTH
- WF - WELL FLUID
- W - WATER INJECTION
- GL - GAS LIFT
- WAC - WELL ARRAY CENTER

REFERENCE DRAWINGS/DOCUMENTS

S.NO.	DWG./DOC. NO.	REV.	TITLE
1	10182-S2-PL-ENG-DWG-21420	1	DRAWING INDEX
2	10182-S2-PL-ENG-DWG-21420	1	FIELD LAYOUT BOMBAY HIGH FIELD
3	10182-S2-PL-ENG-DWG-21420	1	PIPELINE WELLS SCHEDULE
4	10182-S2-PL-ENG-DWG-21420	1	LB PLATFORM (WAC) - LB TO LB (WELLS TO LB)

1	AS-BUILT	BAS	QMS	PVE	24.06.10
0	ISSUED FOR CONSTRUCTION	THAVA	NA	SI	04.09.09
A	ISSUED FOR CLIENT REVIEW	THAVA	NA	SI	01.7.09


REV.	DESCRIPTION	DRN.	CHKD.	APPD.	DATE

ONGC (OW)	ONGC (OD)	LEIGHTON	INTECSEA
OWNER : OIL & NATURAL GAS CORPORATION LTD. ENGG. SECTION, EAC DIVISION MISC. NUMBER			
CONSULTANT :			

CONTRACTOR : LEIGHTON CONTRACTORS INDIA Pvt. Ltd.			
PROJECT : PIPELINE REPLACEMENT PROJECT-2			

TITLE : LB PLATFORM PIPELINE APPROACH AND DEPARTURE (FLEXIBLE PIPELINE)			
---	--	--	--

SCALE	DRAWING NUMBER	REV.
1 : 250	10182-S2-PL-ENG-DWG-21420	1

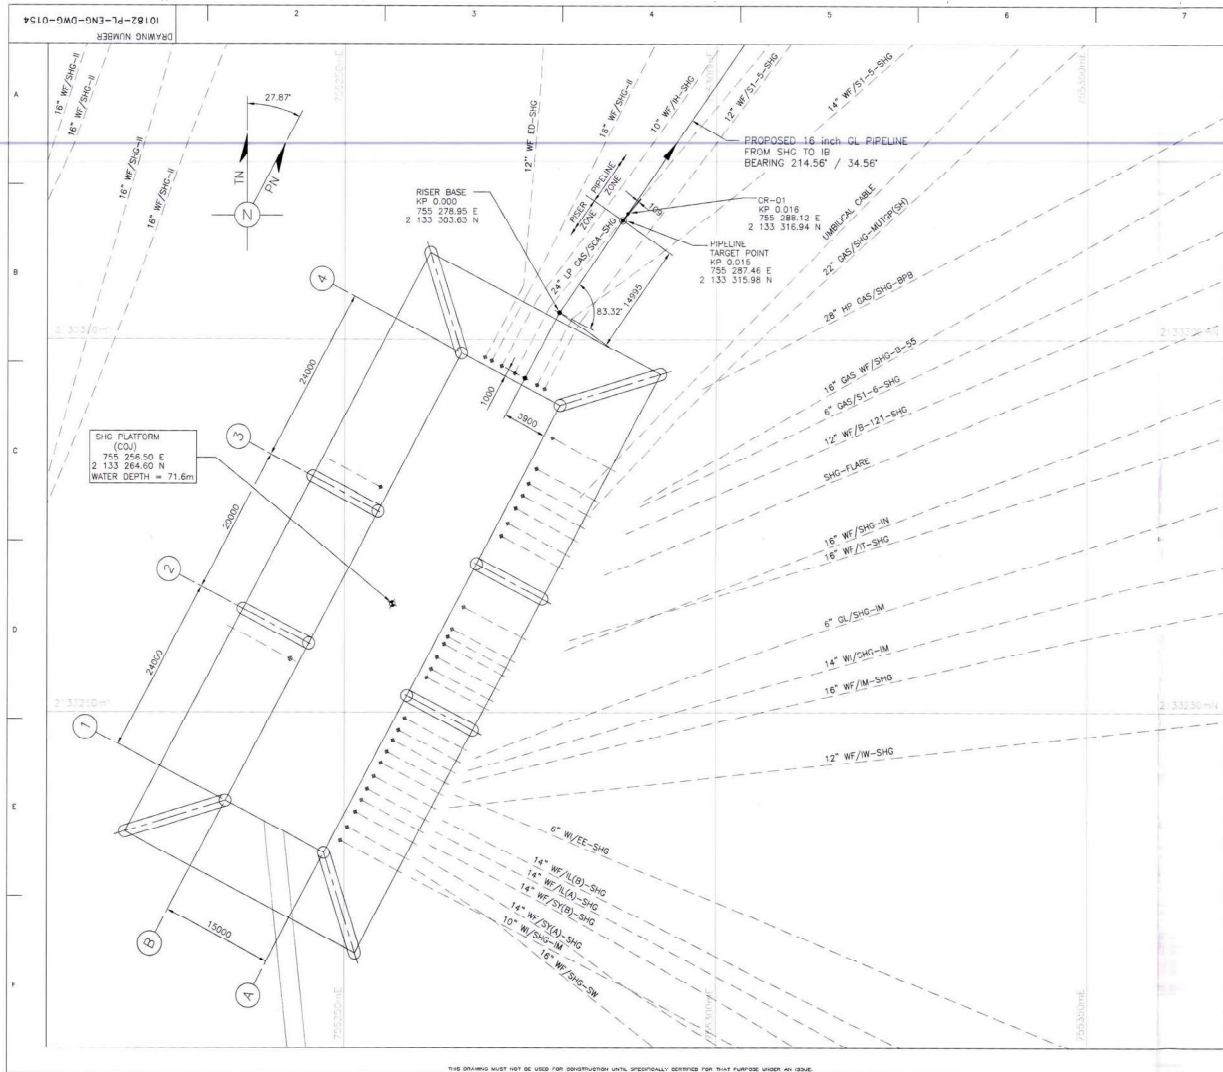



THIS DRAWING MUST NOT BE USED FOR CONSTRUCTION UNTIL SPECIALLY DESIGNED FOR THAT PURPOSE UNDER AN ISSUE.


NOTES	
1. ALL DIMENSIONS ARE IN MILLIMETRES AND COORDINATES ARE IN METRES.	
2. ALL COORDINATES ARE BASED ON UNIVERSAL TRANSVERSE MERCATOR PROJECTION ON EVEREST 1830 SPHEROID, ZONE 42 CENTRAL MERIDIAN 69° EAST ON BOMBAY HIGH DATUM.	
3. THE PIPELINE BEARINGS ARE WITH REFERENCE TO TRUE NORTH.	
4. THE LOCATION OF THE EXISTING PLATFORMS AND PIPELINES ARE BASED ON THE PRE-ENGINEERING SURVEY DRAWINGS BY FLUGRO SURVEY INDIA PVT.LTD.	
5. CARE SHALL BE EXERCISED WHILE LAYING THE PIPELINE IN THE VICINITY OF EXISTING FACILITIES SUCH THAT THE LAYING OPERATION CAUSES NO DAMAGE WHATSOEVER TO THE EXISTING FACILITIES.	


LEGEND	
---	PROPOSED RISER AND RIGID PIPELINE
---	EXISTING PIPELINE
TN	TRUE NORTH
PN	PLATFORM NORTH
WF	WELL FLUID
GL	GAS/LIFT
COU	CORNER OF JACKLEY

REFERENCE DRAWINGS/DOCUMENTS			
Sl.No.	DRG/DOC. No.	Rev.	TITLE
1	0182-PL-ENG-DWG-0146	-	DRAWING INDEX
2	0182-PL-ENG-DWG-0148	-	FIELD LAYOUT - BOMBAY HIGH FIELD
3	0182-PL-ENG-DWG-0180	-	ASSEMBLY DRAWING
4	0182-PL-ENG-DWG-0183	-	PIPELINE ALIGNMENT - 16" GL FROM SHG TO IB
5	0182-PL-ENG-DWG-0184	-	PIPELINE ALIGNMENT - 16" GL FROM SHG TO IB
6	0182-PL-ENG-DWG-0185	-	PIPELINE ALIGNMENT - 16" GL FROM SHG TO IB
100	0182-PL-ENG-DWG-0279	-	PIPELINE ALIGNMENT - 16" GL FROM SHG TO IB

ISSUED FOR CONSTRUCTION	THAKRA	NA	SI	12.12.08	
ISSUED FOR CLIENT REVIEW	HAS	NA	SI	23.12.08	
REV	DESCRIPTION	DRN.	CHGD.	APPRD.	DATE
01	ISSUED FOR CONSTRUCTION				
02	ISSUED FOR CLIENT REVIEW				
03	ISSUED FOR CONSTRUCTION				
04	ISSUED FOR CLIENT REVIEW				
05	ISSUED FOR CONSTRUCTION				
100	ISSUED FOR CLIENT REVIEW				


OWNER : OIL & NATURAL GAS CORPORATION LTD.		
INDUS. SECTION, EX-8 DIVISION		
MUMBAI, INDIA		
CONSULTANT :		
		
CONTRACTOR :		
		
LEIGHTON CONTRACTORS INDIA Pvt. Ltd.		
PIPELINE REPLACEMENT PROJECT-2		
TITLE : SHG PLATFORM		
PIPELINE APPROACH AND DEPARTURE		
(RIGID PIPELINE)		
SCALE	DRAWING NUMBER	REV
1 : 250	0182-PL-ENG-DWG-0184	

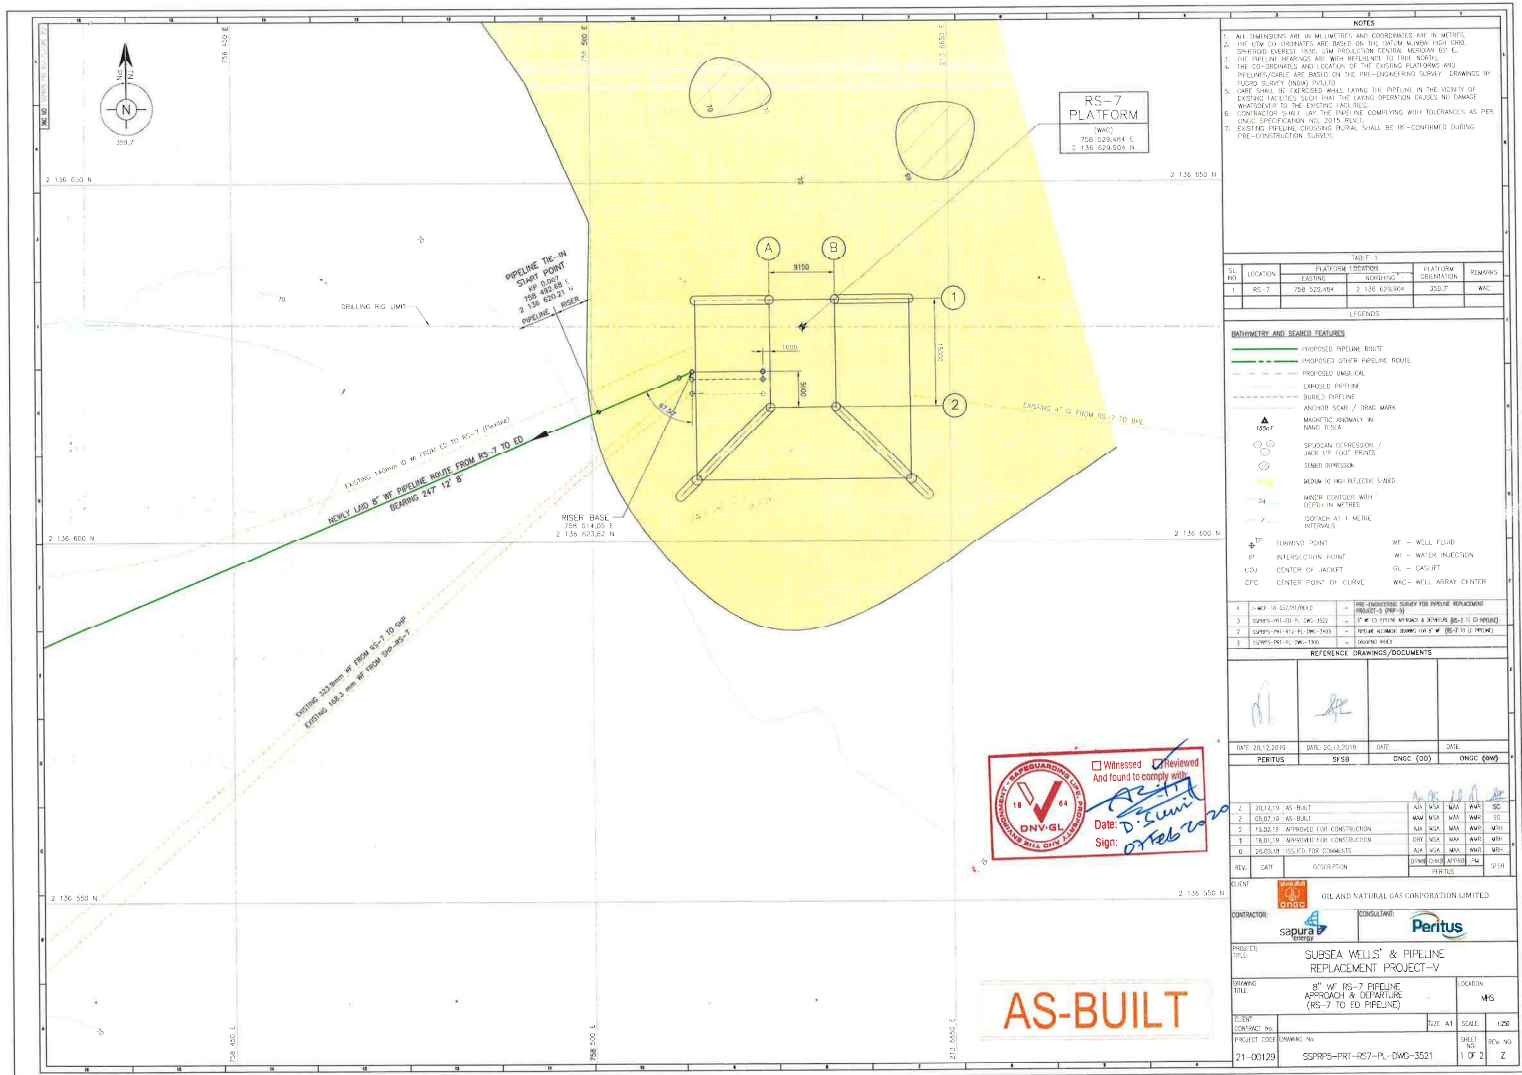

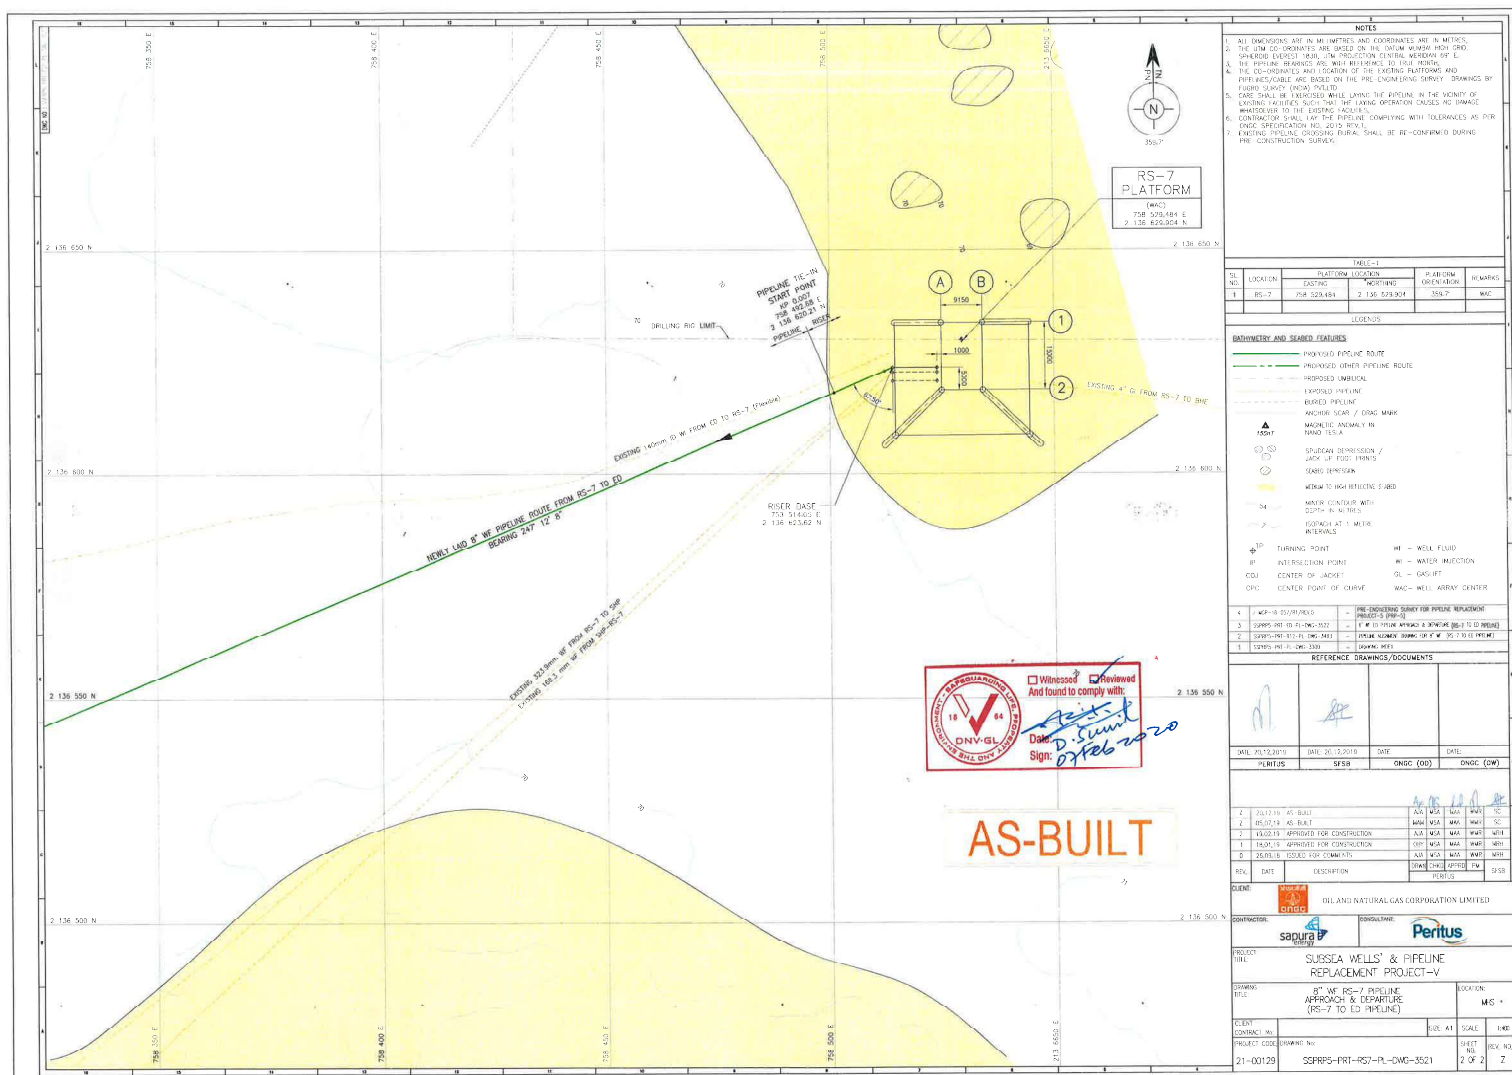


CLIENT DRAWING NO. JPK-DRAWING NO.

DATE: 11-02-2011

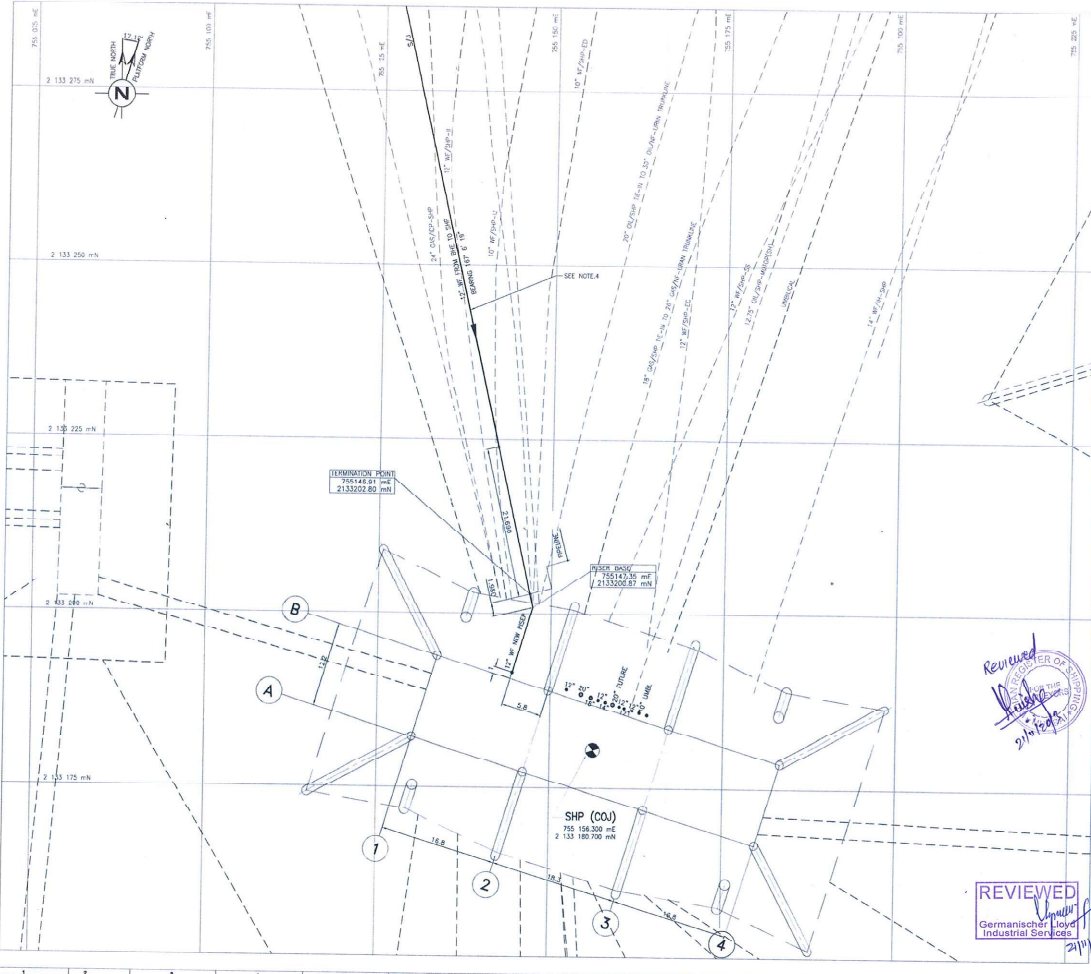

KEY PLAN

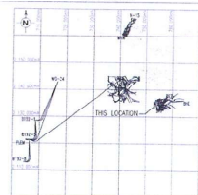

NOTES


1. ALL DIMENSIONS ARE IN METERS UNLESS OTHERWISE NOTED
2. THE UTM COORDINATES ARE BASED ON THE UTM 48Q ZONE 48Q, DATUM: 1983 - MEAN HIGH DATUM
3. ORIENTATION OF THE PLATFORM IS WITH RESPECT TO TRUE NORTH
4. 16" IN SPOOL AND RISER SHALL BE INSTALLED WITH WELDED CONNECTION (ORFAX-ON METHOD)
5. START-UP A LAY-DOWN ENDS OF THE PIPELINE AS SHOWN ON THE DRAWING IS INDICATIVE ONLY. THE START-UP & LAY-DOWN SYNCHRON CAN BE ALTERED BY THE OFFSHORE INSTALLATION CONTRACTOR DEPENDING ON SITE & WEATHER CONDITIONS
6. THE NEW 12" RISER AT SHP PLATFORM SHALL BE INSTALLED AS THE REPLACEMENT OF 14" W RISER.

LEGEND

- PROPOSED PIPELINE
- EXISTING PIPELINE
- GEOMETRY OF JACKET
- START-UP
- WATER INJECTION

REFERENCE DRAWINGS

- | DRAWING TITLE | NO. |
|--|---------------------|
| 1. OFFSHORE FIELD LAYOUT | (11800-11-J-08-000) |
| 2. PIPELINE RE-48 SPOOL DETAIL AT SHP PLATFORM | (11800-11-J-08-001) |

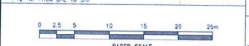

NO.	REVISION	DATE	BY	CHKD	APPD
1	AS BUILT	11/02/2011	AK	AK	AK
2	FOR CONSTRUCTION	11/02/2011	AK	AK	AK
3	FOR CONSTRUCTION	11/02/2011	AK	AK	AK
4	FOR CONSTRUCTION	11/02/2011	AK	AK	AK

AS BUILT


CONSORTIUM OF 4 SHIPBROOKS OFFSHORE INDIA PVT. LTD.
A SHIPBROOKS OFFSHORE CONSTRUCTION PTE. LTD.

PROJECT TITLE: CLUSTER-7 PIPELINES PROJECT

DRAWING TITLE: SHP PLATFORM PIPELINE APPROACH AND DEPARTURE

SCALE: 1:250 SHEET NO. C11800-11-J-08-007 SHEET NO. 1 OF 1

C17029-54-1-HE-4105

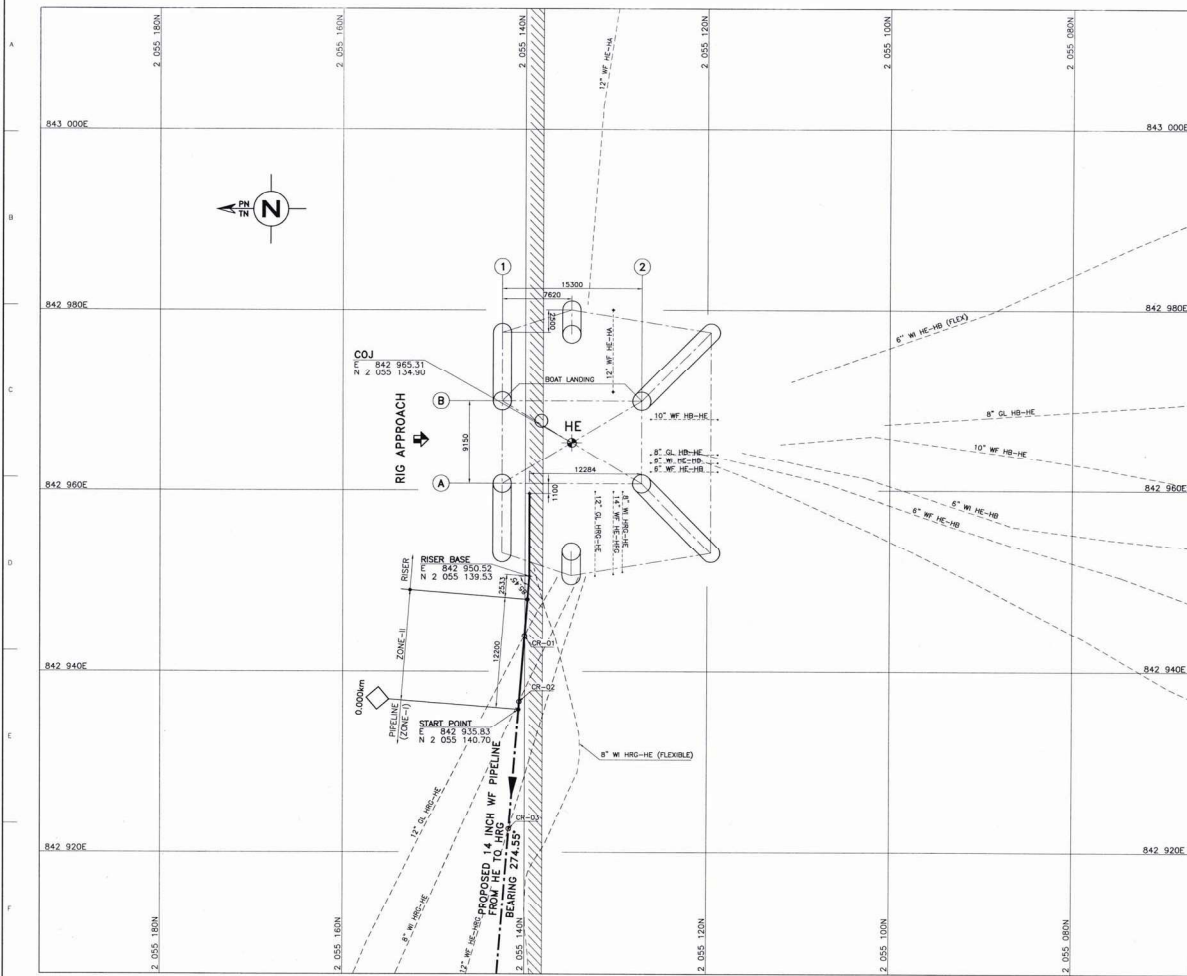

FILE: C17029-54-1-HE-4105 17-08-095-170-017029

- NOTES
1. ALL DIMENSIONS ARE IN MILLIMETRES AND CO-ORDINATES ARE IN METRES.
 2. THE UTM CO-ORDINATES ARE BASED ON THE EVEREST 1830 UNWARPED, UTM ZONE 42N, CENTRAL MERIDIAN 85° EAST ON HEERA FIELD.
 3. THE PIPELINE BEARINGS ARE WITH REFERENCE TO TRUE NORTH.
 4. ALL DIMENSIONS ARE AT JACKET WORKING POINT EL. (+) 10.030m

LEGEND

- PROPOSED RISER/ZONE-II
- - - PROPOSED PIPELINE
- - - EXISTING RISER/PIPELINE
- ◇ KILOMETER POST
- TN TRUE NORTH
- PN PLATFORM NORTH
- COJ CENTER OF JACKET
- km KILOMETER
- WF WELL FLUID
- WI WATER INJECTION
- GL GAS LIFT

ACCEPTED BY LTHE. DC
SIGN:
DATE: 09-01-18

REFERENCE DRAWINGS/DOCUMENTS

S.No.	DRG/DOC. No.	Rev.	Rev.	TITLE
1	C17029-54-1-EN-1000	1		DRAWING INDEX
2	C17029-54-1-HE-3000	1		HE PLATFORM - 14 INCH WF RISER
3	C17029-54-0-EN-4000	1		PIPELINE ALIGNMENT DRAWING
4	PP04-52-PPD-HE-14	1		14 INCH WF HE TO HRO
5	PP04-52-PPD-HE-14	1		14 INCH WF HE TO HRO
6	PP04-52-PPD-HE-14	1		14 INCH WF HE TO HRO
7	PP04-52-PPD-HE-14	1		14 INCH WF HE TO HRO
8	PP04-52-PPD-HE-14	1		14 INCH WF HE TO HRO
9	PP04-52-PPD-HE-14	1		14 INCH WF HE TO HRO
10	PP04-52-PPD-HE-14	1		14 INCH WF HE TO HRO

APPROVED

LTHE-BANGALORE	LTHE	ONGC-OD	ONGC-OW
----------------	------	---------	---------

REV	DESCRIPTION	DRN	CHG	APPD	PM	DATE
0	ISSUED FOR APPROVAL	PB	C/S	PNG	GEN	09.01.18


CLIENT
OIL & NATURAL GAS CORPORATION LTD.
INDIA


EPC CONTRACTOR & ENGS CONSULTANT
 L&T HYDROCARBON ENGINEERING

PROJECT: BALANCE WORK FOR
PIPELINE REPLACEMENT PROJECT - 4

TITLE: HE PLATFORM
PIPELINE APPROACH AND DEPARTURE DRAWING

SCALE: 1:200 TOTAL NO. OF SHTS: 1 OF 1
DRAWING NUMBER: C17029-54-1-HE-4105

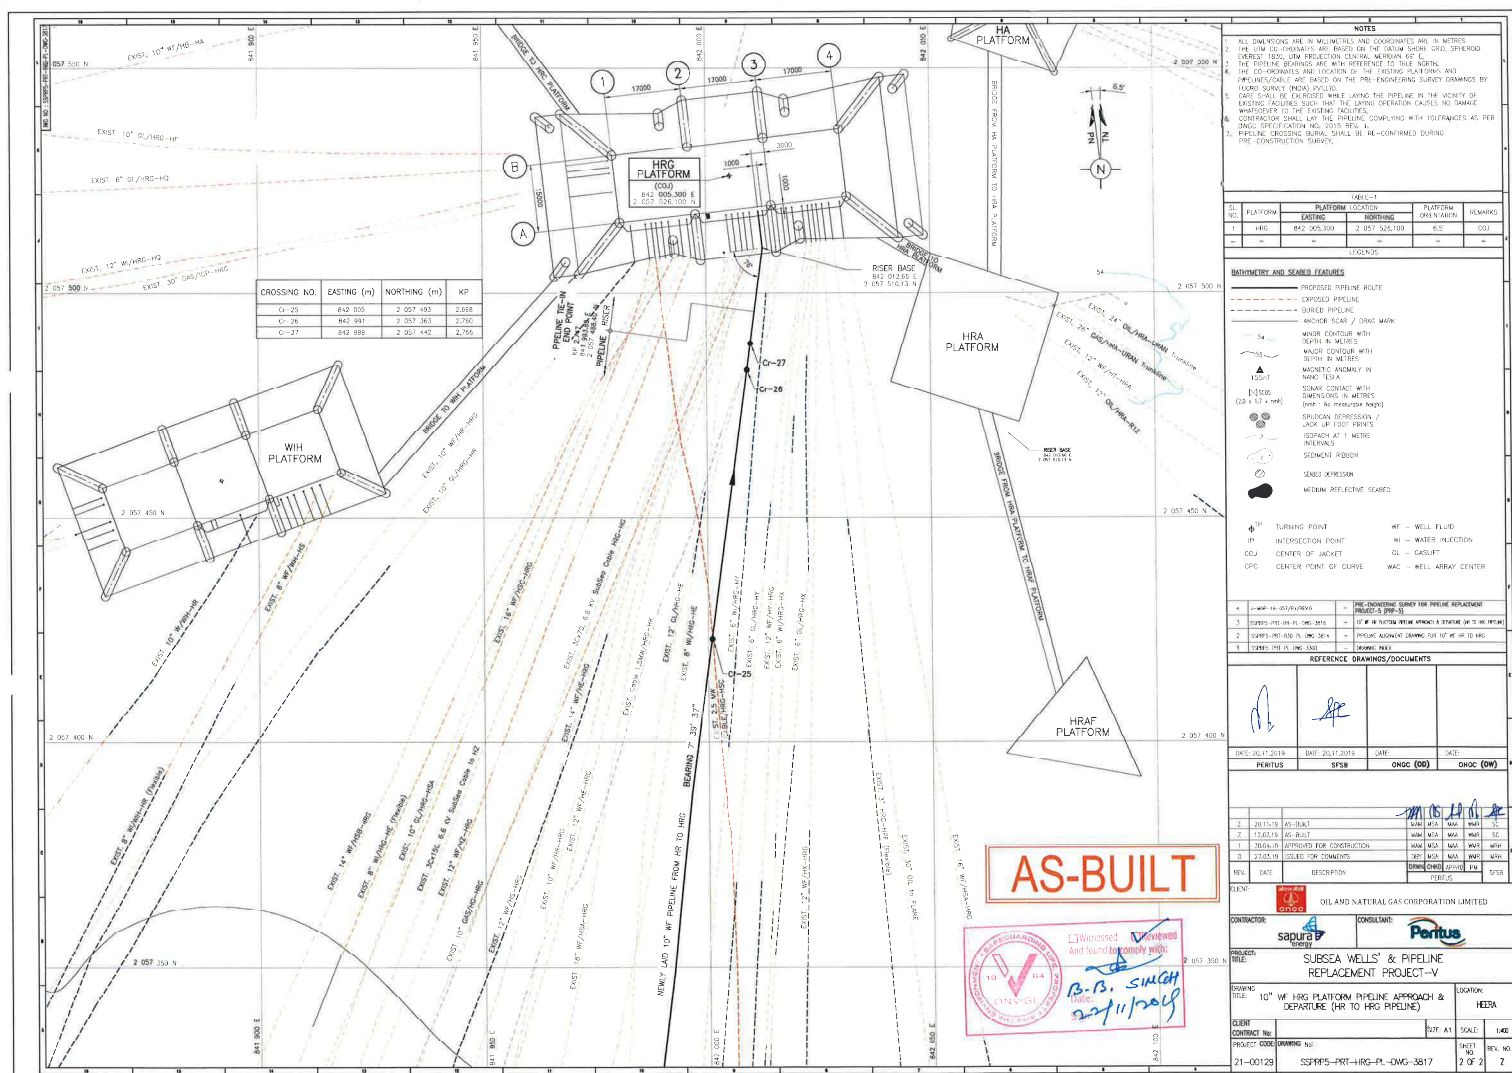

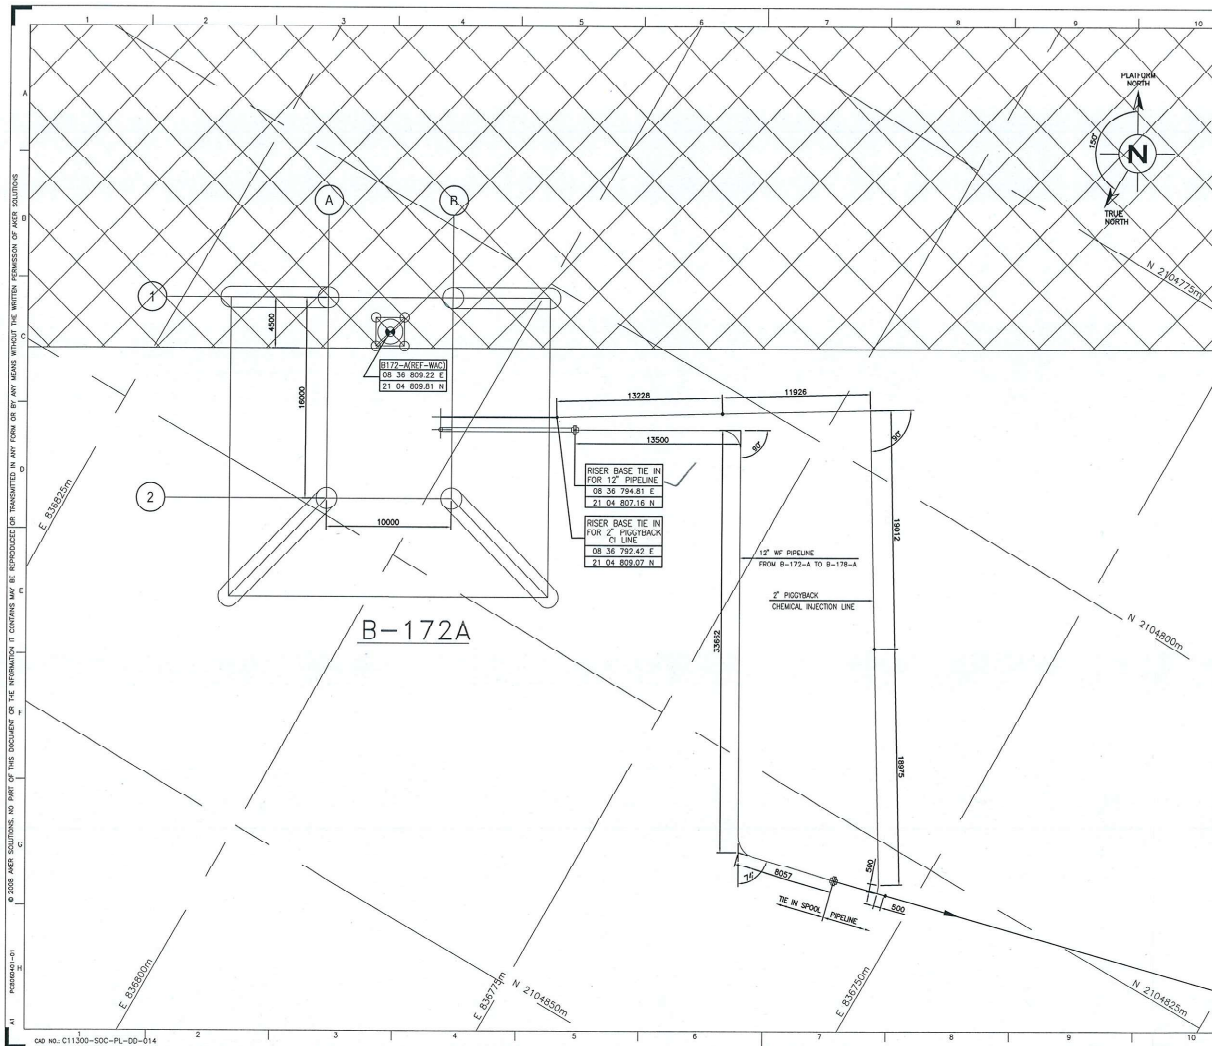

NOTES

1. ALL DIMENSIONS ARE IN METERS UNLESS SPECIFIED AND COORDINATES ARE IN METERS.
2. ALL COORDINATES ARE BASED ON UNIVERSAL TRANSVERSE MERCATOR (UTM) PROJECTION ON EVEREST SPHEROID 1830 C (INDIA).
3. ALL WATER DEPTHS ARE WITH RESPECT TO CHART DATUM.

KEY PLAN

LEGEND

- 0 000 000m = UTM GRID PROJECTION
- CO = CENTER OF ANCHOR
- KP = KILOMETER POST
- WAC = WELL ARRAY CENTER
- WF = WELL FLUID
- CH = CHEMICAL INJECTION
- RD = RIG CLEARANCE ZONE

REFERENCE

REV	DATE	DESCRIPTION	BY	CHKD	APPD
1	13/12/13	AS BUILT	SD	PT-3	FW

OWNER: OIL AND NATURAL GAS CORPORATION LIMITED INDIA

CONTRACTOR: Swiber Offshore Construction Pte Ltd

ENGINEERING CONSULTANT: AkerSolutions

PROJECT: B193-SUB-SEA PIPELINES PROJECT


DWG TITLE: PLATFORM APPROACH & DEPARTURE DRAWING FOR B-172-A PLATFORM

SCALE: 1:150

DRAWING NUMBER: C11300-SOC-PL-DD-014

SHEET NO: 1 OF 1

REV: X

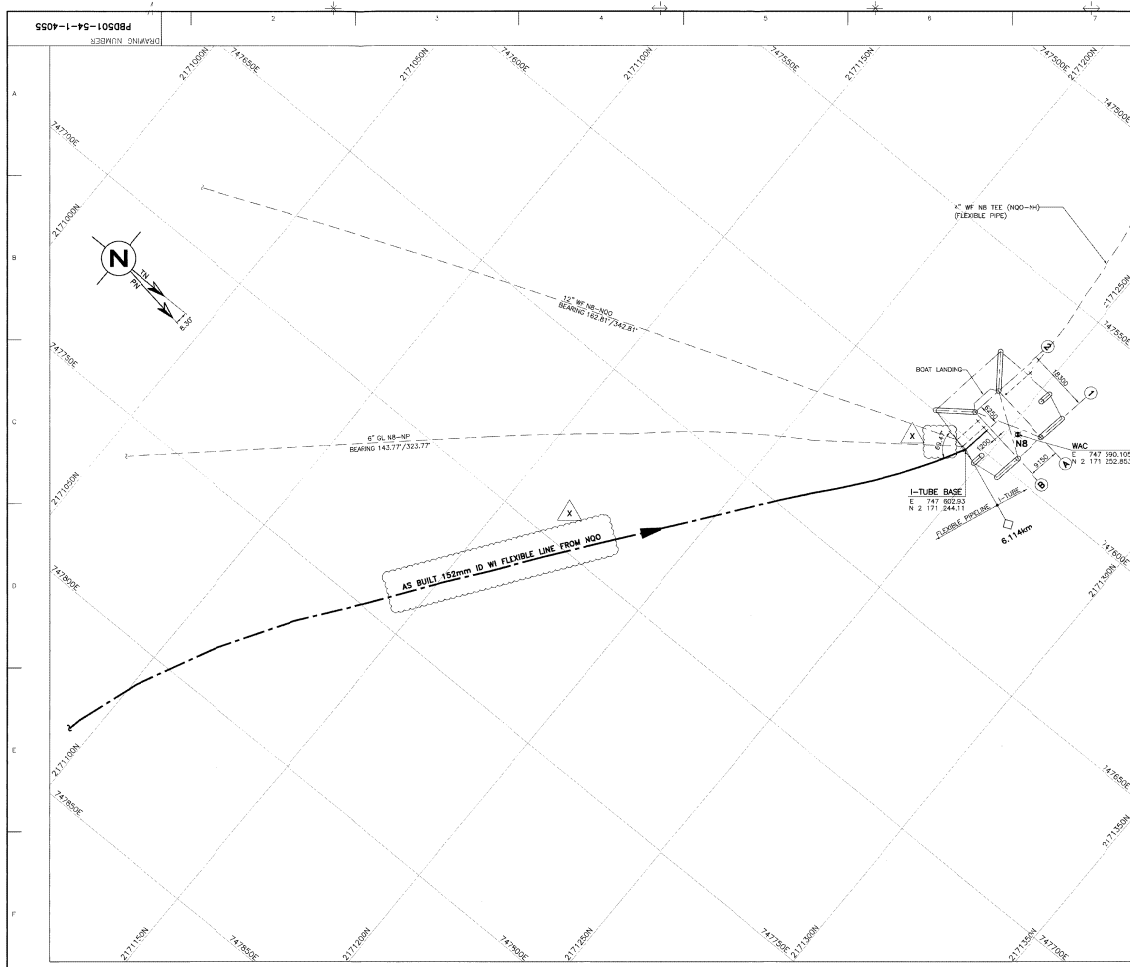

THIS DRAWING MUST NOT BE USED FOR CONSTRUCTION UNLESS SPECIFICALLY IDENTIFIED FOR THAT PURPOSE UNDER AN ISOL.

NOTES

1. ALL DIMENSIONS ARE IN MILLIMETRES AND CO-ORDINATES ARE IN METRES.
2. THE EXISTING PIPELINE DIA SHOWN ARE IN INCHES.
3. ALL CO-ORDINATES ARE BASED ON UNIVERSAL TRANSVERSE MERCATOR PROJECTION ON EVEREST 1830 SPHEROID, ZONE 42 CENTRAL MERIDIAN 85° EAST ON BOMBAY HIGH DATUM.
4. THE PIPELINE BEARINGS ARE WITH REFERENCE TO TRUE NORTH.
- 5.
- 6.
7. DELETED
8. ALL DIMENSIONS ARE AT JACKET WORKING POINT.

AS BUILT

LEGEND

- AS BUILT RISER
- AS BUILT PIPELINE
- EXISTING LINE / RISER
- KILOMETRE POST
- MAC
- WELL ARMY CENTER
- EL
- ELEVATION
- WI
- WATER INJECTION
- km
- KILOMETRE
- M
- METRE
- TYP
- TYPICAL
- TN
- TRUE NORTH
- PN
- PLATFORM NORTH
- W.P.
- JACKET WORKING POINT

REFERENCE DRAWINGS/DOCUMENTS

S.No	DRG/DOC. No.	Rev	Title
1	PB0501-54-1-1000	-	DRAWING INDEX (3 SHEETS)
2	PB0501-54-0-2001	-	FIELD LAYOUT
3	PB0501-54-1-2021	-	NS PLATFORM-300mm (22") I-TUBE ASSEMBLY DRAWING
4	PB0501-54-0-4000	-	FLEXIBLE PIPELINE ALIGNMENT DRAWING 150mm ID W/ KGS TO NS (3 SHEETS)

X	AS BUILT				10.10.06
0	APPROVED FOR CONSTRUCTION	SVW	PVG	SB	19.11.05
C2	RE-ISSUED FOR CLIENT'S COMMENTS	SVW	PVG	SB	18.11.05
C1	ISSUED FOR CLIENT'S COMMENTS	SVW	PVG	SB	14.10.05
REV.	DESCRIPTION	DRN.	CHKD.	APPD.	DATE

ONGC (OW)	ONGC (OD)	L & T	L&T-VALDEL
-----------	-----------	-------	------------

ONGC OIL & NATURAL GAS CORPORATION LTD.
OFFSHORE MARKETING DIVISION
MUMBAI REGION


CONTRACTOR: **CONSORTIUM OF LARSEN & TOUBRO LIMITED AND GLOBAL INDUSTRIES OFFSHORE L.L.C.**

LARSEN & TOUBRO LIMITED
5000, Mumbai

VALDEL
L&T-Valdel Engineering Private Limited
10, Poonam Nagar, Baramulla-220 005

TITLE: **PIPELINE REPLACEMENT PROJECT**
NS PLATFORM
PIPELINE APPROACH AND DEPARTURE DRAWING

SCALE: **1:500** DRAWING NUMBER: **PB0501-54-1-4055** REV: **X**

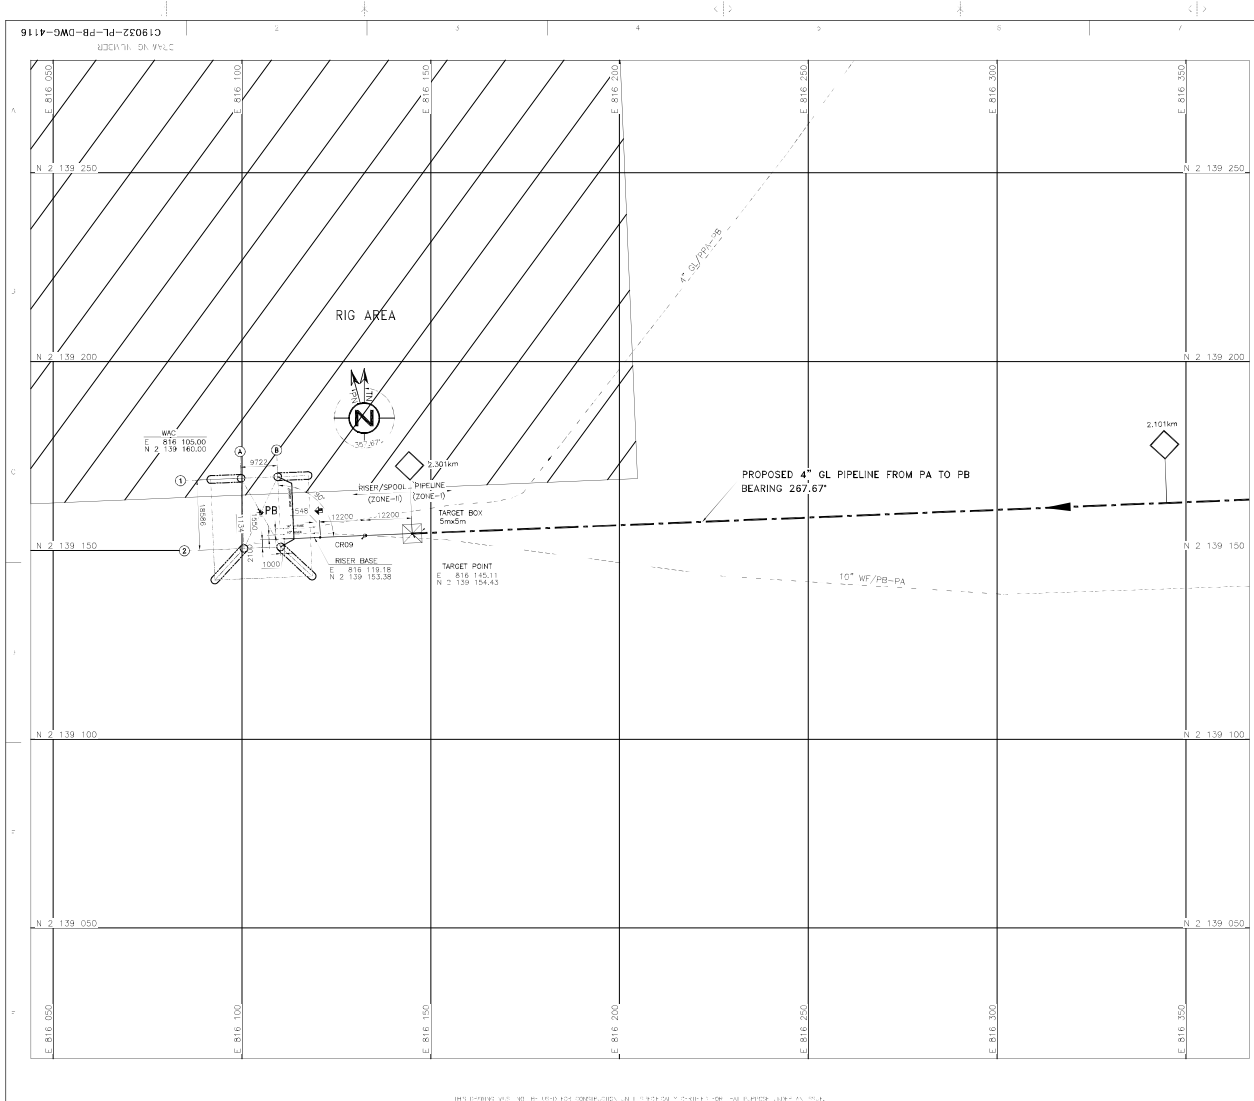

C19032-PL-PB-DWG-4116

NOTES

1. ALL DIMENSIONS ARE IN mm, AND CO-ORDINATES IN METRES. WATER DEPTHS INDICATED ARE IN METRES AND DECIMETRES. WITH RESPECT TO CHART DATUM.

2. PIPELINE POINTS ARE BASED ON PRE-ENGINEERING SURVEY REPORT BY TUGRO SURVEY (INDIA) PVT. LTD.

3. THE PIPELINE BEARINGS ARE WITH REFERENCE TO TRUE NORTH.

4. THE UTM CO-ORDINATES ARE BASED ON THE DATUM WGS-84, UTM PROJECTION, CM 109P, ZONE 42N.

5. EXISTING PLATFORM JACKET SIZE AND RISER LOCATION DIMENSIONS ARE AT JACKET WORKING POINT EL (+) 9.600m (CHART DATUM).

LEGEND

PROPOSED RISER/SPOOL

PROPOSED PIPELINE

EXISTING PIPELINE

PROPOSED PIPELINE

BURIED PIPELINE

KILOMETER POST

TRUE NORTH

PLATFORM NORTH

WELL APPAY CENTER

KILOMETER

WELL FLUAD

WATER INJECTION

GAS LIFT

REFERENCE DRAWINGS/DOCUMENTS

Sl. No.	DWG. No.	Rev.	FILE
1	C19032-PL-GEN-DWG-1000	—	DRAWING INDEX
2	C19032-PL-GEN-DWG-2007	—	FIELD LAYOUT — PANINA
3	C19032-PL-PA-DWG-3216	—	RISER ASSEMBLY DRAWING (PA TO PB) FOR 4" GL PB
4	C19032-PL-GEN-DWG-4008	—	PIPELINE ALIGNMENT DRAWING 4" GL PA TO PB

APPROVED

SUNIL BALWAN

T

DESHPAN

DE

ROHI

T

PANT

BHASKAR

AR

MALLI

CK

ONGC-OD

ONGC-OW

ACCEPTED BY CLIENT

DATE: 28.03.23

NAME: [Signature]

L&T-Engg

L&T-Project

0

ISSUED FOR APPROVAL

MAH. WAC. P.V.G. SSA

04.04.23

01

ISSUED FOR CLIENT COMMENTS

MAH. WAC. P.V.G. SSA

28.03.23

REV

DESCRIPTION

DATE

CLIENT

OIL & NATURAL GAS CORPORATION LTD. INDIA

EPC CONTRACTOR & ENGS CONSULTANT

LARSEN & TOUBRO LIMITED

PROJECT: PIPELINE REPLACEMENT PROJECT VII (PRP-VII RTR)


FILE: PIPELINE APPROACH AND DEPARTURE DRAWING (PA TO PB) FOR PB PLATFORM

SCALE: 1:500

TOTAL NO. OF SHEETS: 1 OF 1

DRAWING NUMBER: C19032-PL-PB-DWG-4116

0

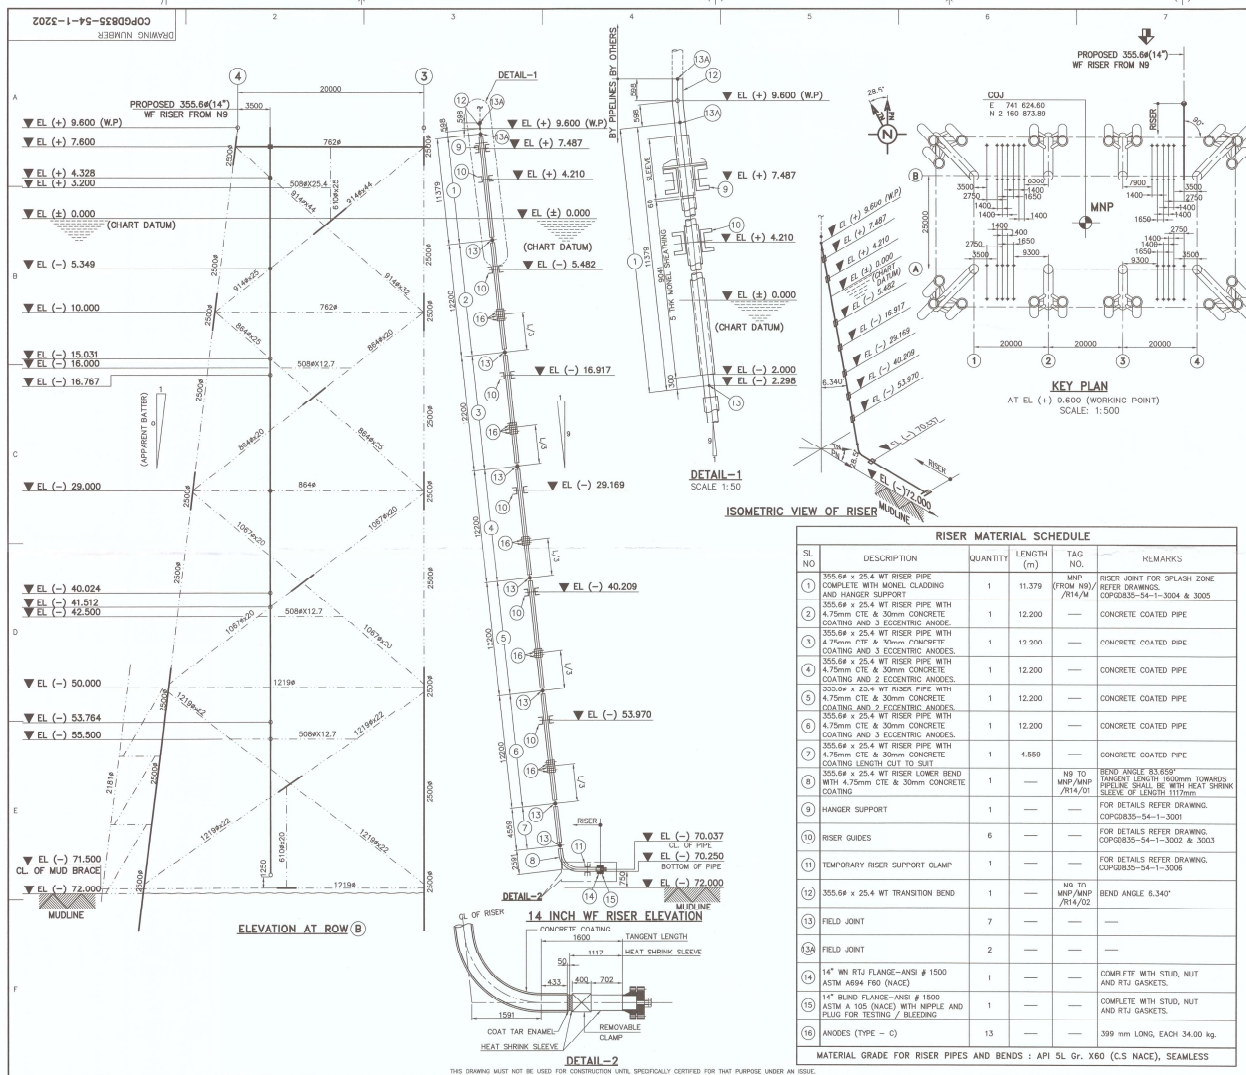

FILE : 3202-MNP(N9) | LTV-5042-1-COP0835/7

NOTES

1. ALL DIMENSIONS ARE IN MILLIMETRES AND LEVELS ARE IN METRES UNDO.

AS-BUILT

LEGEND

- DIAMETER
WT - WALL THICKNESS
mm - MILLIMETRE
TN - TRUE NORTH
COJ - CENTER OF JACKET
W/P - WORKING POINT
O.D - OUTSIDE DIAMETER
EL - ELEVATION

TYP - TYPICAL
WF - WELL FLUID
PN - PLATFORM NORTH
THK - THICKNESS
NO - NUMBER
kg - KILOGRAM
UNDO - UNLESS NOTED OTHERWISE

REFERENCE DRAWINGS/DOCUMENTS

SLNO	DRG/DOC. No.	Rev	TITLE
1	COP0835-54-1-1000	X	DRAWING INDEX
2	COP0835-54-1-3001	X	RISER CLAMP DETAILS
3	COP0835-54-1-3004	X	TYPICAL MONEL SHEATHING DETAILS
4	monel-cl-1-1000	X	RISER ASSEMBLY-TYPICAL
5	COP0835-54-1-3006	X	TYPICAL REMOVABLE RISER SUPPORT DETAILS
6	COP0835-54-1-3102	X	MNP PLATFORM (FROM N9) - LOCATION OF 14 INCH WF RISER AND RISER CLAMPS

REVIEWED

AS-BUILT

REV	DESCRIPTION	DRN	CHKD	APPD	PM	DATE
X	AS-BUILT	MS	KSN	PVG	CD	18.01.13
0	APPROVED FOR CONSTRUCTION	YKA	JP	PVG	CD	29.09.10
C3	RE-ISSUED FOR CLIENT'S COMMENTS	YKA	SVN/JP	PVG	CD	15.06.10
C2	RE-ISSUED FOR CLIENT'S COMMENTS	YKA	SVN/JP	PVG	CD	15.04.10
C1	ISSUED FOR CLIENT'S COMMENTS	YKA	SVN/JP	PVG	CD	18.03.10

OWNER

OIL & NATURAL GAS CORPORATION LTD. INDIA

EPIC CONTRACTOR

LARSEN & TOUBRO LIMITED E&C UPSTREAM, MUMBAI

ENGINEERING CONSULTANT

VALDEL

L&T Valdel Engineering Limited
18, Poonam Road, Begumpet-500 005, INDIA.

PROJECT: MINI-PROCESS PLATFORM AND LIVING QUARTERS PROJECT

TITLE:




MNP PLATFORM (FROM N9)

14 INCH WF RISER ASSEMBLY DRAWING


SCALE: 1 : 200 TOTAL NO. OF SHTS.: 1 OF 1

DRAWING NUMBER: COP0835-54-1-3202

REV: X

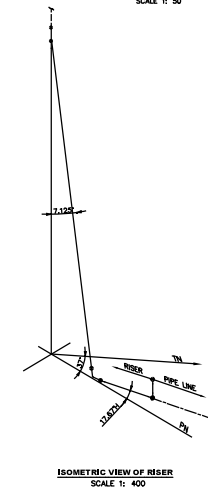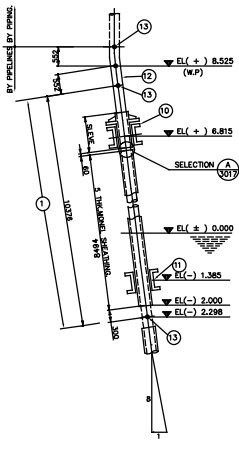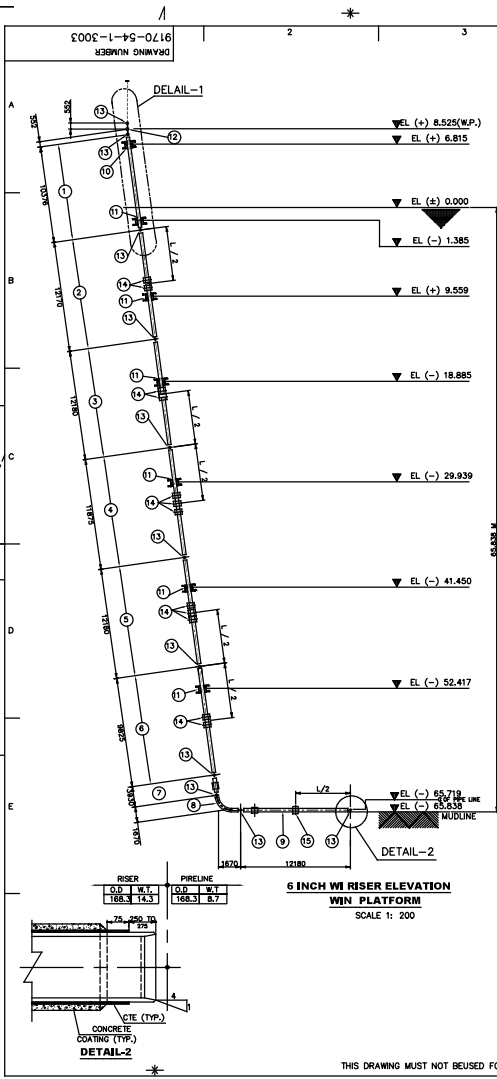

RISER MATERIAL SCHEDULE					
SL. NO.	DESCRIPTION	QUANTITY	APPROX. LENGTH (M.)	TAG. NO.	REMARKS.
①	168.3ø x 14.3 WT RISER PIPE COMPLETE WITH MONEL CLADDING AND HANGER SUPPORT.	1	10.376	WN / RB / M	RISER JOINT FOR SPLASH ZONE REFER DRAWINGS 9170-54-1-3016 & 9170-54-1-3017
②	168.3ø x 14.3 WT RISER PIPE WITH 4.75mm CTE & 25mm CONCRETE COATING AND 2 CENTRAL ANODES.	1	12.170	---	CONCRETE COATED PIPE
③	168.3ø x 14.3 WT RISER PIPE WITH 4.75mm CTE & 25mm CONCRETE COATING AND 2 CENTRAL ANODES.	1	12.180	---	CONCRETE COATED PIPE
④	168.3ø x 14.3 WT RISER PIPE WITH 4.75mm CTE & 25mm CONCRETE COATING AND 3 CENTRAL ANODES.	1	11.875	---	CONCRETE COATED PIPE
⑤	168.3ø x 14.3 WT RISER PIPE WITH 4.75mm CTE & 25mm CONCRETE COATING AND 3 CENTRAL ANODES.	1	12.180	---	CONCRETE COATED PIPE
⑥	168.3ø x 14.3 WT RISER PIPE WITH 4.75mm CTE & 25mm CONCRETE COATING AND 2 CENTRAL ANODES.	1	9.825	---	CONCRETE COATED PIPE
⑦	168.3ø x 14.3 WT RISER PIPE WITH 4.75mm CTE & 25mm CONCRETE COATING AND 1 CENTRAL ANODE.	1	3.930	---	CONCRETE COATED PIPE. THE JOINT LENGTH SHALL BE PREPARED TO MATCH TOTAL LENGTH OF RISER
⑧	168.3ø x 14.3 WT RISER PIPE WITH 4.75mm CTE & 30mm CONCRETE COATING.	1	---	WN / RB	BEND ANGLE 83.21°
⑨	168.3ø x 14.3 WT RISER PIPE WITH 4.75mm CTE & 30mm CONCRETE COATING AND 1 CENTRAL ANODE.	1	12.180	---	THE FIELD WELD END OF PIPE JOINT SHALL BE BEVELLED TO SUIT PIPE LINE WALL THICKNESS.
⑩	HANGER SUPPORT.	1	---	---	FOR DETAILS REFER DRAWING 9170-54-1-2035
⑪	RISER GUIDES.	6	---	---	FOR DETAILS REFER DRAWING 9170-54-1-2036 AND 2037
⑫	TRANSITION BEND.	1	---	HF / R10	COATING TO COMPLY WITH ANODING SPECIFICATION 2006/REV-0 BEND ANGLE 7.125°
⑬	FIELD JOINT.	11	---	---	TO COMPLY WITH ANODING SPECIFICATION 2006/REV-0 2018 REV-1
⑭	ANODES (TYPE - V8)	12	---	---	387mm LONG/EACH 12.40Kg.
⑮	ANODES, ZONE-B (TYPE - I)	1	---	---	387mm LONG/EACH 15.61 Kg.

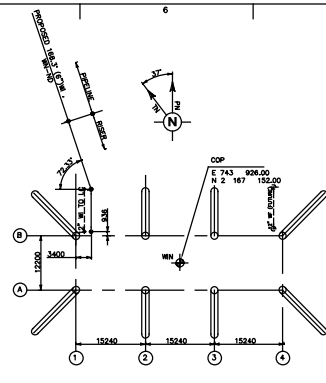

NOTES

- ALL DIMENSIONS ARE IN mm. AND LEVELS ARE IN METERS UNDO.
- ALL LEVELS ARE RELATED TO CHART DATUM.
- INSTALLATION CONTRACTOR SHALL ENSURE THAT EDGE OF ALL ANODES AND FIELD JOINTS TO HAVE A MINIMUM CLEARANCE OF 500mm FROM THE CENTRE LINE OF CLAMP / GUIDE.
- THE HANGER FLANGE SHALL BE FIELD WELDED TO THE RISER SLEEVE AFTER LEVEL ADJUSTMENT OF RISER DURING INSTALLATION.
- MONEL SHEET FABRICATOR SHALL USE RISER PIPE JOINT LENGTH OF 10.376 M FOR 6" RISER.
- INSTALLATION CONTRACTOR SHALL PREPARE THE CONCRETE SURFACE OF THE RISER SMOOTH AND EVEN FOR A MINIMUM DISTANCE OF 200mm ON EITHER SIDE OF RISER JOINT LOCATION.
- INSTALLATION CONTRACTOR SHALL ENSURE THAT THE RISER IS ACCIDENTLY BRACED (OR BRACE) AT RISER LOWER BOND AND SHALL REMOVE THE SAME AFTER INSTALLATION OF THE RISER AND RECEIVE IT TO THE SURFACE.
- THE OVER ALL LENGTH OF RISER SECTION FROM HANGER CLAMP TO SEA BED LVL SHALL BE MEASURED PRIOR TO THE RISER ASSEMBLY.
- RISER ASSEMBLY CONTRACTOR SHALL MEASURE THE PIPE JOINT LENGTH AND MARK RISER TITLE ON COATED PIPE JOINTS ONSHORE PRIOR TO TRANSPORTATION.
- NO. OF FIELD JOINTS INDICATED IN THE RISER MATERIAL SCHEDULE IS TENTATIVE AND MAY VARY DEPENDING ON FIELD MEASUREMENTS AND INDIVIDUAL RISER PIPE LENGTH.
- THE RISER / PIPELINE SHALL BE CONTINUOUSLY SUPPORTED BY SEA BED AFTER RISER BOND.
- DURING INSTALLATION MCL SHALL ENSURE THAT DESIGNED RISER BRAND ARE MAINTAINED.
- ONLY DEVALUATION ON ACCOUNT OF PRE-ENGINEERING SURVEY OUTPUT SHALL BE ENSURED BY MCL WITHOUT ANY TIME & COST EFFECT.


LEGEND

Ø — DIAMETER EL — ELEVATION
WT. — WALL THICKNESS L — PIPE JOINT LENGTH
CTE — COAL TAR ENAMEL TYP. — TYPICAL
mm. — MILLIMETER GL. — GAS LIFT
TN. — TRUE NORTH PH. — PLATFORM NORTH
COP. — CENTER OF PLATFORM THK. — THICKNESS
W.P. — WORKING POINT NO. — NUMBER
O.D. — OUTSIDE DIAMETER KG. — KILOGRAM
UNDO. — UNLESS NOTED OTHERWISE.


REFERENCE DRAWING/DOCUMENTS

S.NO	DRG./DOC. NO.	Rev. No.	TITLE
1.	9170-54-1-2035	01	DESIGN SPEC.
2.	9170-54-1-2036	01	WIN PLATFORM LOCATION OF RISER CLAMP
3.	9170-54-1-2037	01	SEA BED SURFACE PREPARATION
4.	9170-54-1-2038	01	SEA BED SURFACE PREPARATION
5.	9170-54-1-2039	01	SEA BED SURFACE PREPARATION
171.	9170-54-1-2205	01	SEA BED SURFACE PREPARATION
172.	9170-54-1-2206		

C17022-54-1-B1211-3202
DRAWING NUMBER

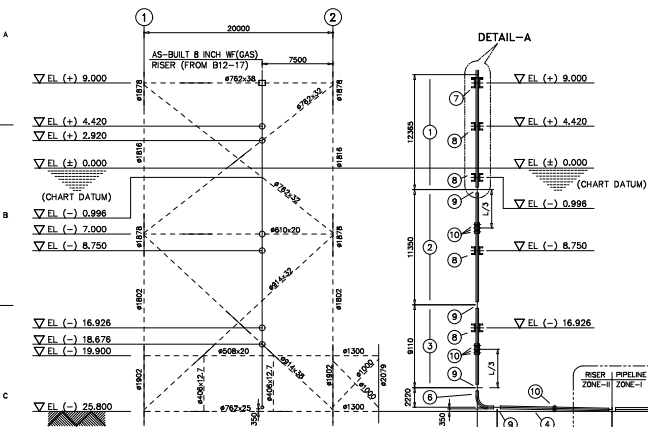

ELEVATION AT ROW (A)

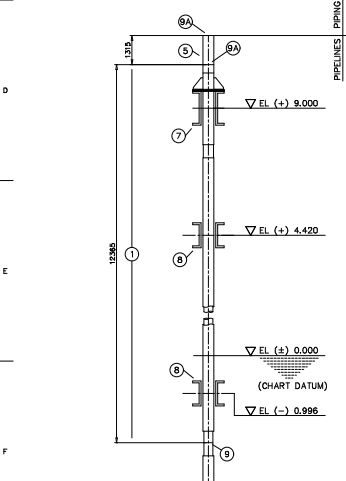

ISOMETRIC VIEW OF RISER
SCALE: NTS

DETAIL-B
(REFER SHEET-02 OF
C17022-54-1-B1211-3202)

KEY PLAN
AT EL. (+) 9.000

RISER MATERIAL SCHEDULE					
SL No.	DESCRIPTION	QUANTITY	LENGTH (m)	TAG No.	REMARKS
①	219.14 x 22.2 WT RISER PIPE COMPLETE WITH 5mm MONEL CLADDING AND HANGER SUPPORT	1	12.365	B12-11/R6/M	—
②	219.14 x 22.2 WT RISER PIPE WITH 5mm 3LPP & 30mm CONCRETE COATING AND 3 ECCENTRIC ANODES	1	11.350	—	—
③	219.14 x 22.2 WT RISER PIPE WITH 5mm 3LPP & 30mm CONCRETE COATING AND 3 ECCENTRIC ANODES	1	9.110	—	—
④	219.14 x 22.2 WT RISER PIPE WITH 5mm 3LPP & 30mm CONCRETE COATING AND 1 CENTRAL ANODE	1	12.180	—	—
⑤	219.14 x 22.2 WT RISER PIPE	1	1.315	—	—
⑥	219.14 x 22.2 WT RISER BEND WITH 2.5mm HEAT SHRINK SLEEVE & 30mm CONCRETE COATING	1	—	B12-11/R6/M	BEND ANGLE 90° (BEND RADIUS 1985.5mm WITH 1000mm TANGENT LENGTH ON BOTH SIDES)
⑦	HANGER SUPPORT	1	—	—	—
⑧	RISER GUIDES	4	—	—	—
⑨	FIELD JOINT	5	—	—	—
⑩	FIELD JOINT	2	—	—	—
⑪	ANODE (TYPE-A)	7	—	—	—
⑫	CONCRETE MATTRESS (10m x 2.5m x 0.5m)	1	—	—	—

MATERIAL GRADE FOR RISER PIPES AND BENDS : API 5L Gr. X60 (C.S. NACE), SEAMLESS

FILE : C17022-54-1-B1211-3202 | F-50-095-1/0-C17022
NOTES

1. ALL DIMENSIONS ARE IN MM AND LEVELS ARE IN METRES UALD.
2. ALL LEVELS ARE WITH RESPECT TO CHART DATUM.
3. THE UTM CO-ORDINATES ARE BASED ON THE EVEREST 1830 SPHEROID.
4. UTM ZONE 45N, CENTRAL MERIDIAN WP EAST ON MUMBAI HIGH DATUM

LEGEND

#	DIAMETER	WF	WELL FLUID
WT	WALL THICKNESS	PN	PLATFORM NORTH
mm	MILLIMETRE	EL	ELEVATION
m	METRE	TYP	TYPICAL
WAC	WELL ARMY CENTER	TN	TRUE NORTH
UALD	UNLESS NOTED OTHERWISE	HSS	HEAT SHRINK SLEEVE
3LPP	THREE LAYER POLY PROPYLENE	HDPF	HIGH DENSITY POLYURETHANE FOAM
L	PIPE LENGTH	THK	THICKNESS

REFERENCE DRAWINGS/DOCUMENTS

S.No	DRG./DOC. No.	Rev	TITLE
1	C17022-54-1-024-1000	—	DRAWING INDEX
2	C17022-54-1-B1211-3202	—	B12-11 PLATFORM - 8 INCH WF RISER ASSEMBLY DRAWING (SHT-02)
3	C17022-54-1-B1211-3202	—	B12-11 PLATFORM - LOCATION OF 8 INCH WF RISER AND RISER CLAMPS

AS-BUILT

X	AS-BUILT	PB	CS	PVG	SB	17.09.18
0	ISSUED FOR APPROVAL	PB	CS	PVG	SB	06.02.18
REV	DESCRIPTION	DRN	CHD	APPD	FW	DATE


CLIENT
OIL & NATURAL GAS CORPORATION LTD.
INDIA

EPC CONTRACTOR & ENVO CONSULTANT
L&T HYDROCARBON ENGINEERING

PROJECT: TRANSPORTATION & INSTALLATION - DAMAN
DEVELOPMENT PROJECT

TITLE:
**B12-11 PLATFORM
8 INCH WF RISER ASSEMBLY DRAWING**

SCALE: 1:200 TOTAL NO. OF SHTS.: 01 OF 02
DRAWING NUMBER C17022-54-1-B1211-3202 REV. X

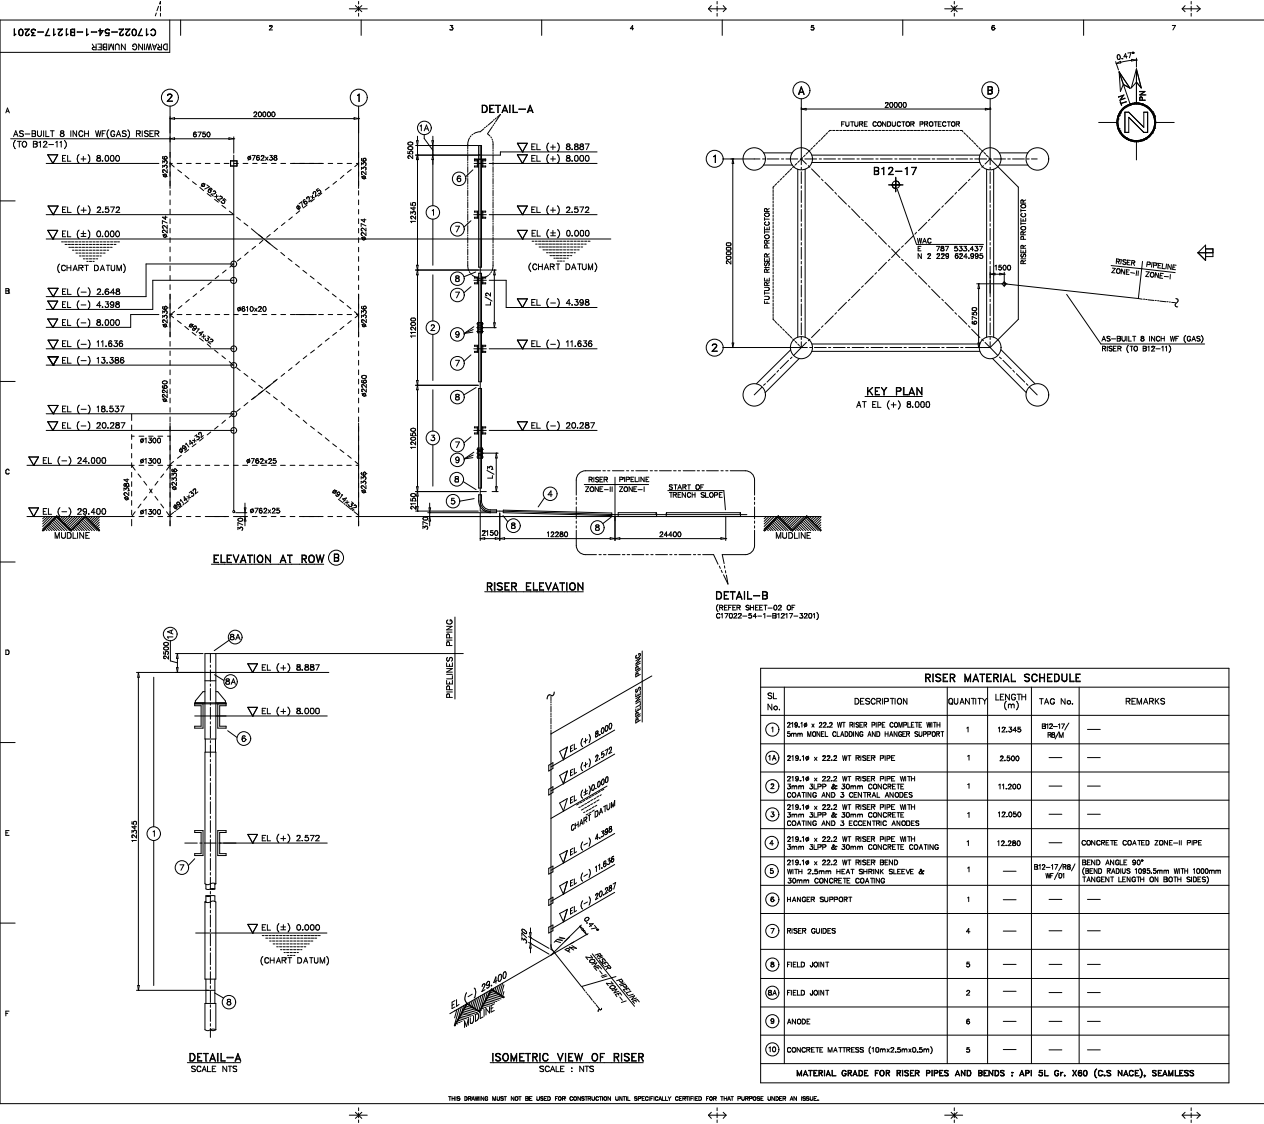

FILE : C17022-54-1-B1217-3201 F-50-099-1/0-C17022									
NOTES									
1. ALL DIMENSIONS ARE IN MM AND LEVELS ARE IN METRES UALD.									
2. ALL LEVELS ARE WITH RESPECT TO CHART DATUM.									
3. THE UTM CO-ORDINATES ARE BASED ON THE EVEREST 1830 SPHEROID, UTM ZONE 45N, CENTRAL MERIDIAN 80° EAST ON MUMBAI HIGH DATUM									
LEGEND									
#	DIAMETER				WF	WELL FLUID			
WT	WALL THICKNESS				PNL	PLATFORM NORTH			
mm	MILLIMETRE				EL	ELEVATION			
m	METRE				TYP	TYPICAL			
WAC	WELL ARRAY CENTER				TRN	TRUE NORTH			
UALD	UNLESS NOTED OTHERWISE				HSS	HEAT SHRINK SLEEVE			
SUPP	THREE LAYER POLY PROPYLENE				HDPF	HIGH DENSITY POLYURETHANE FOAM			
L	PIPE LENGTH								
THK	THICKNESS								
REFERENCE DRAWINGS/DOCUMENTS									
S.No	DRG./DOC. No.	Rev. No.	TITLE						
1	C17022-54-1-GEN-1000	-	DRAWING INDEX						
2	C17022-54-1-B1217-3201	-	B12-17 PLATFORM - 8 INCH WF RISER ASSEMBLY DRAWING (SHT-02)						
3	C17022-54-1-B1217-3201	-	B12-17 PLATFORM - LOCATION OF 8 INCH WF RISER AND RISER CLAMPS						
AS-BUILT									
CLIENT									
X	AS-BUILT		PB	ENV/SP	PVG	SB	17.09.18		
0	ISSUED FOR APPROVAL		PB	ENV/SP	PVG	SB	06.02.21		
REV	DESCRIPTION		DRN	CHKD	APPD	PM	DATE		
OIL & NATURAL GAS CORPORATION LTD. INDIA									
EPC CONTRACTOR & ENVO CONSULTANT									
L&T HYDROCARBON ENGINEERING									
PROJECT: TRANSPORTATION & INSTALLATION - DAMAN DEVELOPMENT PROJECT									
TITLE:									
B12-17 PLATFORM 8 INCH WF RISER ASSEMBLY DRAWING									
SCALE: 1:200 TOTAL NO. OF SHTS: 01 OF 02									
DRAWING NUMBER C17022-54-1-B1217-3201									
REV. X									

DATE : 01/06-21/09

NOTES :

1. ALL DIMENSIONS ARE IN METRES AND LEVELS ARE IN METRES U.S.A.
2. ALL LEVELS ARE WITH RESPECT TO CHART DATUM.
3. INSTALLATION CONTRACTOR SHALL ENSURE THAT EDGE OF ALL ANODES IS ADJUSTED TO BEAT 100% OF THE ANODE LENGTH OF 500mm FROM THE EDGE OF CLAMP/PLATE.
4. MOIST EXHAUST FABRICATOR/INSTALLER SHALL USE RISER PIPE JOINT (LENGTH) OF MINIMUM LENGTH 10.23m-60" FOR 16" WF RISER.
5. CONTRACTOR TO ENSURE CONFORM COMPOSITE SURFACE FOR THE RISER PIPE FOR A PROPER FITUP OF RISER CLAMPS, LONGER AND SHORTER.
6. INSTALLATION CONTRACTOR SHALL ENSURE THAT THE RISER IS ADJUSTED TO BEAT 100% OF THE RISER CLAMP LONGER AND SHORTER. THE RISER SHALL BE REMOVED THE SAME AFTER INSTALLATION OF THE RISER AND RETRIEVE IT TO THE SHIP YARD (FOR REUSE).
7. THE OVERALL LENGTH OF RISER SECTION FROM HANGER CLAMP TO SEARDED LINE, SHALL BE MEASURED PRIOR TO TRANSPORTATION.
8. THE CONTRACTOR SHALL MEASURE THE RISER PIPE LENGTHS AND MARK OR CHART PIPE JOINTS CORRESPONDING PRIOR TO TRANSPORTATION.
9. NO. OF FIELD JOINTS INDICATED IN THE RISER MATERIAL SCHEDULE IS SUBJECT TO VARIATION BASED UPON FIELD MEASUREMENTS, AND INDIVIDUAL RISER PIPE LENGTH. INSTALLATION CONTRACTOR SHALL JOCKET THE FINAL RISER UP TO BE USED ON THE PIPE LENGTH PRIOR TO COMPLETION OF CONSTRUCTION.
10. CONTRACTOR, IF REQUIRED TO BE USED FOR RISER INSTALLATION SHALL BE RE-LOCATED AT THE NEAREST SUITABLE LOCATION.
11. AFTER THE INSTALLATION OF RISER CLAMP, LONGER AND SHORTER, BUISSEY SHALL BE REMOVED AND RETRIEVED IF NECESSARY. THE BUISSEY SHALL BE USED AS A RISER CLAMP FOR THE RISER. IT IS NECESSARY AND RE-INSTALLED AFTER RISER INSTALLATION AS PER BID REQUIREMENT.
12. REFER TO DRAWING 0102-32-PL-ENG-DWG-21709 FOR GROUT BAG SUPPORT DETAILS.

AS-BUILT

LEGEND

■ - HANGER CLAMP (HC)	PL - PLATFORM NORTH
● - FIRED CLAMP (FC)	WF - WATER INJECTION
○ - ADJUSTABLE CLAMP (AC)	WF - WELL FLUID
WP - WORKING POINT	GL - GAS LIFT
TR - TRUCK NORTH	CH - CENTER OF HELICOPT

REFERENCE DRAWINGS/DOCUMENTS

S/NO.	DWG./DOC. NO.	REV.	TITLE
1	0102-32-PL-ENG-DWG-21709		- DRAWING INDEX
2	0102-32-PL-ENG-DWG-21020, 21503, 21504 & 21505		- RISER CLAMP DETAILS
3	0102-32-PL-ENG-DWG-21007		- TYPICAL KNEE BRACE DETAIL FOR RISERS
4	0102-32-PL-ENG-DWG-21029		- RISER PIPE COATING SCHEDULE
5	0102-32-PL-ENG-DWG-21350		- PIPELINE ALIGNMENT 16" WF FROM NH TO IND
6	0102-32-PL-ENG-DWG-21429		- NH PLATFORM LIFTING APPROACH AND DEPARTURE
7	0102-32-PL-ENG-DWG-21531		- NH PLATFORM - LOCATION OF 16" WF RISER & RISER CLAMPS
8	0102-32-PL-ENG-DWG-21727		- NH PLATFORM - 16" WF RISER HANG OFF CLIMBING DETAIL
9	0102-32-PL-ENG-DWG-21859		- 16" WF FROM NH TO IND PIPELINE CROSSING DETAILS

■ - AS-BUILT	BAS	ONG	PWC	04.06.10
NO ISSUES FOR CONSTRUCTION	TOP	YWF	SI	16.06.09
NO ISSUES FOR CLIENT REVIEW	TOP	YWF	SI	10.08.09

REV.	ISSUED FOR DESCRIPTION	DRN.	CHWG.	APPD.	DATE

(Signature)

ONGC (OW) ONGC (OD) LEIGHTON INTECSEA

OWNER : OIL & NATURAL GAS CORPORATION LTD.
ONGC SECTION ENCL. DIVISION
ONGC, MUMBAI

CONSULTANT : **intecSEA**
an Intertec Group Company


CONTRACTOR : **LEIGHTON CONTRACTORS INDIA Pvt. Ltd.**



PROJECT : **PIPELINE REPLACEMENT PROJECT-2**

TITLE : **NH PLATFORM
16" WF RISER ASSEMBLY**

SCALE	DRAWING NUMBER	REV.
-------	----------------	------

AS SHOWN	0102-32-PL-ENG-DWG-21709	1
----------	--------------------------	---

		PROJECT : 906-10-21 FORMER-372			
NOTES					
1. ALL DIMENSIONS ARE IN MILLIMETERS UNLESS ARE IN METERS UNLESS STATED.					
2. ALL DIMENSIONS ARE RELATED TO CHART DATUM.					
3. INSTALLATION CONTRACTOR SHALL ENSURE THAT EDGE OF ALL JOINTS AND JOINT JOINTS TO BE MADE WITH A MINIMUM CLEARANCE OF 500MM. FROM THE CENTRE LINE OF CLAMP / GUIDE.					
4. THE HANGER FLANGE SHALL BE FIELD WELDED TO THE RISER SLEEVE AFTER LEVELADJUSTMENT OF RISER DURING INSTALLATION.					
5. WONES SHEET FABRICATION CONTRACTOR SHALL USE RISER PIPE JOINT(LENGTH) OF 8.22MM FOR 8" RISER.					
6. INSTALLATION CONTRACTOR SHALL PROTECT THE CONCRETE SURFACE OF THE RISER SMOOTH AND EVEN FOR A MINIMUM DISTANCE OF 500MM. ON EITHER SIDE OF RISER JOINT LOCATION.					
7. INSTALLATION CONTRACTOR SHALL ENSURE THAT THE RISER IS ACCELERATED BRACED (ONES BRACED) AT RISER LOWER END AND SHALL REMOVE THE SAME AFTER INSTALLATION OF THE RISER AND RETIEVE IT TO THE SURFACE.					
8. THE OVER ALL LENGTH OF RISER INSTALLED FROM HANGER CLAMP SEA BED LEVEL, SHALL BE MEASURED PRIOR TO RISER ASSEMBLY.					
9. RISER ASSEMBLY CONTAINING JOINTS SHALL BE MEASURED PIPE JOINT LENGTH AND MARK RISER TITLE ON COATED PIPE JOINTS ORIGIN.					
10. NO OF FIELD JOINTS INDICATED IN THE MATERIAL MATERIAL SCHEDULE IS TENTATIVE AND MAY VARY DEPENDING ON FIELD MEASUREMENTS AND INDIVIDUAL RISER PIPE LENGTH.					
11. RISER / PIPELINE SHALL BE CONTINUOUSLY SUPPORTED BY SEA BED AFTER RISER RIGID.					
12. DURING INSTALLATION MPD SHALL ENSURE THAT DESIGNER RISER SPANS ARE MAINTAINED.					
LEGEND					
W	= DIAMETER	EL	= ELEVATION		
IN	= WALL THICKNESS	PI	= PIPE JOINT LENGTH		
STE	= CLAMP TAIL ANGLE	TP	= TYPICAL		
MM	= MILLIMETER	W	= WATERHEAD		
TH	= TRUE NORTH	PN	= PLATFORM NORTH		
COP	= CENTER OF PLATFORM	THK	= THICKNESS		
W.P.	= WORKING POINT	NO.	= NUMBER		
O.D.	= OUTSIDE DIAMETER	KG	= KILOGRAM		
UNLESS NOTED OTHERWISE.					
REFERENCE DRAWING/DOCUMENTS					
S.NO	DRY/DWG. NO.	Rev	NO.		
1	10-10-2001	0	1		
2	10-10-2001	0	2		
3	10-10-2001	0	3		
100	10-10-2001	0	100		
AS BUILT					
A	DRAWING MADE AS BUILT.		7/8/2003		
0	APPROVED FOR CONSTRUCTION.		30/08/04		
C2	ISSUED FOR CLIENT'S COMMENTS.	OS	RS	NSR	30/08/04
C1	ISSUED FOR CLIENT'S COMMENTS.	OS	RS	NSR	28/08/04
REV.	DESCRIPTION	DRN	CHD	APPD	DATE
KPI	MDL	ONCC(É&P)	ONCC		
 OIL & NATURAL GAS CORPORATION LTD ONGC, SECTOR 8 CHANDIGARH PUNJAB INDIA					
MAZAGON DOCK LIMITED					
CLAMP-ON FLANGE MODIFICATIONS & PIPELINES					
PROJECT (CRMP)					
Kvaerner process (India) Limited					
15, Pitambar Road, Bangalore-560 003					
KVAERNE®					
TITLE : ND PLAT FORM					
6 INCH WI RISER ASSEMBLY DRAWING.					
SCALE		DRAWING NUMBER		REV	
1 : 200		9170-54-1-3004		A	

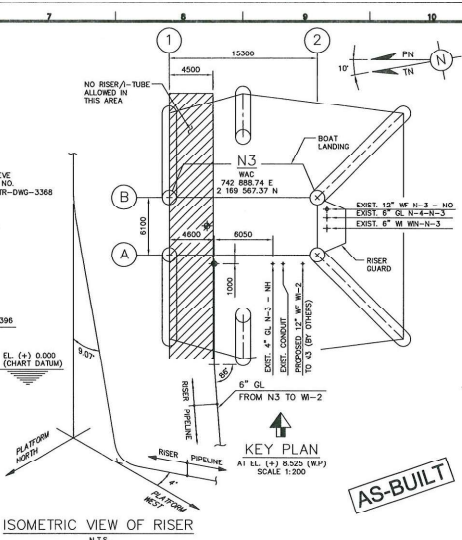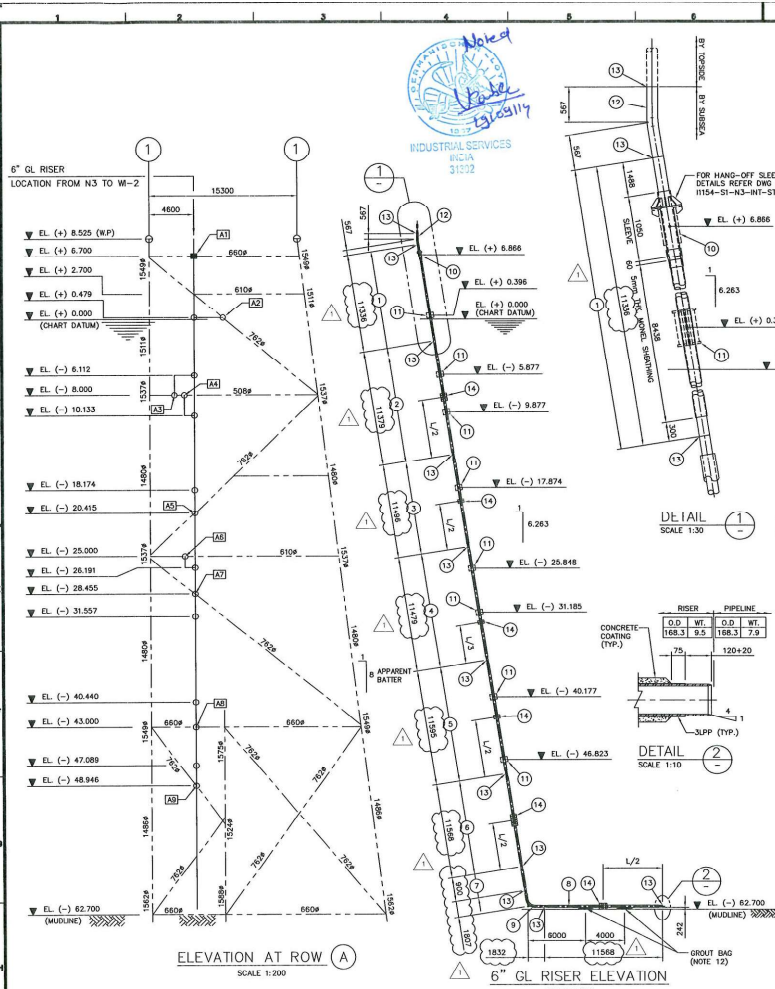

MATERIAL SCHEDULE FOR RISER					
NO.	DESCRIPTION	QTY.	APPROX. LENGTH/TA	REMARKS	
1	168.36 x 14.3 WT RISER PIPE WITH 5mm THK MONEL SHEATHING AND HANGER SUPPORT	1	11.336m	MONEL SHEATHED PIPE	
2	168.36 x 9.5 WT RISER PIPE WITH 2.5mm THK SLPPP, 30mm CONCRETE COATING AND CLUSTER OF 2 CENTRAL ANODES	1	11.379m	CONCRETE COATED PIPE	
3	168.36 x 9.5 WT RISER PIPE WITH 2.5mm THK SLPPP, 30mm CONCRETE COATING AND 1 CENTRAL ANODE	1	11.496m	CONCRETE COATED PIPE	
4	168.36 x 9.5 WT RISER PIPE WITH 2.5mm THK SLPPP, 30mm CONCRETE COATING AND 1 CENTRAL ANODE	1	11.478m	CONCRETE COATED PIPE	
5	168.36 x 9.5 WT RISER PIPE WITH 2.5mm THK SLPPP, 30mm CONCRETE COATING AND 1 CENTRAL ANODE	1	11.595m	CONCRETE COATED PIPE	
6	168.36 x 9.5 WT RISER PIPE WITH 2.5mm THK SLPPP, 30mm CONCRETE COATING AND 1 CENTRAL ANODE	1	11.588m	CONCRETE COATED PIPE	
7	168.36 x 9.5 WT RISER PIPE WITH 2.5mm THK SLPPP, 30mm CONCRETE COATING AND 1 CENTRAL ANODE	1	0.900m	THE JOINT LENGTH SHALL BE PREPARED TO MATCH TOTAL LENGTH OF RISER	
8	168.36 x 9.5 WT RISER PIPE WITH 2.5mm THK SLPPP, 30mm CONCRETE COATING AND 1 CENTRAL ANODE	1	11.568m	THE FIELD WELD END OF PIPE JOINT SHALL BE INTERNALLY CHAMFERED TO SUIT PIPELINE WALL THICKNESS	
9	168.36 x 9.5 WT 90 BEND, 841.5mm RADIUS, 1000mm TANGENT LENGTH WITH 2.5mm THK SLPPP, 30mm CONCRETE COATING	1	3.410m	BEND ANGLE 90.00°	
10	HANGER SUPPORT	1		FOR DETAILS REFER DRAWING 11154-S1-GEN-INT-STR-DWG-3272	
11	RISER GUIDES	8		FOR DETAILS REFER DWG NO. 11154-S1-GEN-INT-STR-DWG-3273 & 3274	
12	168.36 x 14.3 WT 50° TRANSITION BEND, 841.5mm RADIUS, WITH 50mm TANGENT LENGTH	1	1.133m	BEND ANGLE 9.07° COATING TO COMPLY WITH ONGC SPECIFICATION 2009 F REV-7 & 2014 REV-3 INCLUDING ADDENDUM RESPECTIVELY	
13	FIELD JOINT	11		TO COMPLY WITH ONGC SPECIFICATION 2009 F REV-7 & 2014 REV-3 INCLUDING ADDENDUM RESPECTIVELY	
14	ANODES (TYPE S1-3)	10		350mm LONG EACH 12.4kg	

NOTES

- ALL DIMENSIONS ARE IN METRES AND LEVELS ARE IN METRES ILLD.
- ALL LEVELS ARE WITH RESPECT TO CHART DATUM.
- INSTALLATION CONTRACTOR SHALL ENSURE MINIMUM CLEARANCE OF 300mm (END TO END) BETWEEN THE FOLLOWING:
 - FIELD JOINT AND THE CLAMP
 - FIELD JOINT AND THE ANODE
 - CLAMP AND THE ANODE
- MONEL SHEATH FABRICATION CONTRACTOR SHALL USE RISER PIPE JOINT LENGTHS OF MINIMUM LENGTH 10.392m FOR 6" GL RISER.
- CONTRACTOR TO ENSURE UNIFORM CONCRETE SURFACE FOR THE RISER PIPE FOR A PROPER FIT OF RISER CLAMPS.
- INSTALLATION CONTRACTOR SHALL ENSURE THAT THE RISER IS ASSEMBLED TO THE SURFACE (SEE REQUIREMENT).
- THE OVERALL LENGTH OF RISER SECTION FROM HANGER CLAMP TO SEALED END SHALL BE MEASURED PRIOR TO RISER ASSEMBLY.
- THE CONTRACTOR SHALL MEASURE THE PIPE JOINT LENGTHS AND MARK ON COATED PIPE JOINTS ENSURE PRIOR TO TRANSPORTATION.
- NO. OF FIELD JOINTS INDICATED IN THE RISER MATERIAL SCHEDULE IS TENTATIVE AND MAY VARY DEPENDING ON FIELD MEASUREMENTS AND REMOVAL OF RISER PIPE LENGTH. INSTALLATION CONTRACTOR SHALL SUBMIT THE FINAL RISER MAKE UP BASED ON THE PIPE LENGTH PRIOR TO COMMENCEMENT OF CONSTRUCTION.
- JACKET ANODES, IF REQUIRED TO BE REMOVED FOR RISER INSTALLATION SHALL BE RE-LOCATED AT THE NEAREST SURFACE LOCATION.
- PRIOR TO INSTALLATION OF RISER THE BOAT LANDING AND BARGE BUMPER SHALL BE REMOVED AND RETRIEVE IF NECESSARY. THE BOAT LANDING AND BARGE BUMPER SHALL BE RE-INSTALLED AFTER RISER INSTALLATION AS PER BID REQUIREMENT.
- REFER TO DRAWING NO. 11161-61-R14-INT-PLC-DWG-3446 FOR GROUT BAG SUPPORT DETAILS.
- MINIMUM GAP BETWEEN TWO ADJACENT ANODES IN THE CLUSTER SHALL BE 75mm TO 100mm END TO END OF THE ANODES.
- THE UTM CO-ORDINATES ARE BASED ON THE EVEREST 1830 SPHEROID, UTM ZONE 42, CENTRAL MERIDIAN 69° EAST ON MUMBAI MEAN DATUM.
- INSTALLATION CONTRACTOR IF NECESSARY SHALL DO SUITABLE ADJUSTMENTS TO THE LOCATION OF THE RISER ANODES AT SITE BASED ON THE ACTUAL METROLOGY AND ACTUAL PIPE JOINT LENGTHS.

LEGEND

- HANGER CLAMP (HC)
- FIXED CLAMP (FC)
- ADJUSTABLE CLAMP (AC)
- W - WATER INJECTION
- WF - WELL FLUID
- GL - GAS LIFT
- WN - WELL NORTH
- WAC - WELL ARRAY CENTER

REFERENCE DRAWINGS/DOCUMENTS

REV.	DESCRIPTION	DATE
1	AS BUILT	20.06.14
2	APPROVED FOR CONSTRUCTION	19.02.13
3	RE-DESIGNED FOR CLAMP REVIEW	21.12.12
4	ISSUED FOR LIGHTNING REVIEW	23.10.12

REVISION

REV.	DESCRIPTION	DATE
1	AS BUILT	20.06.14
2	APPROVED FOR CONSTRUCTION	19.02.13
3	RE-DESIGNED FOR CLAMP REVIEW	21.12.12
4	ISSUED FOR LIGHTNING REVIEW	23.10.12

OWNER : OIL AND NATURAL GAS CORPORATION LIMITED

CONTRACTOR : Leighton India Contractors Pvt Ltd

CONSULTANT : INTECSEA

PROJECT : PIPELINE REPLACEMENT PROJECT-3


TITLE : N3 PLATFORM 6" GL RISER ASSEMBLY

SCALE : DRAWING NUMBER : REV


AS SHOWN : 11154-S1-N3-INT-PLC-DWG-3361 1

THIS DRAWING MUST NOT BE USED FOR CONSTRUCTION UNTIL SPECIFICALLY CERTIFIED FOR THAT PURPOSE UNDER AN ISSUE.


0102-1-1-3010
DRAWING NUMBER

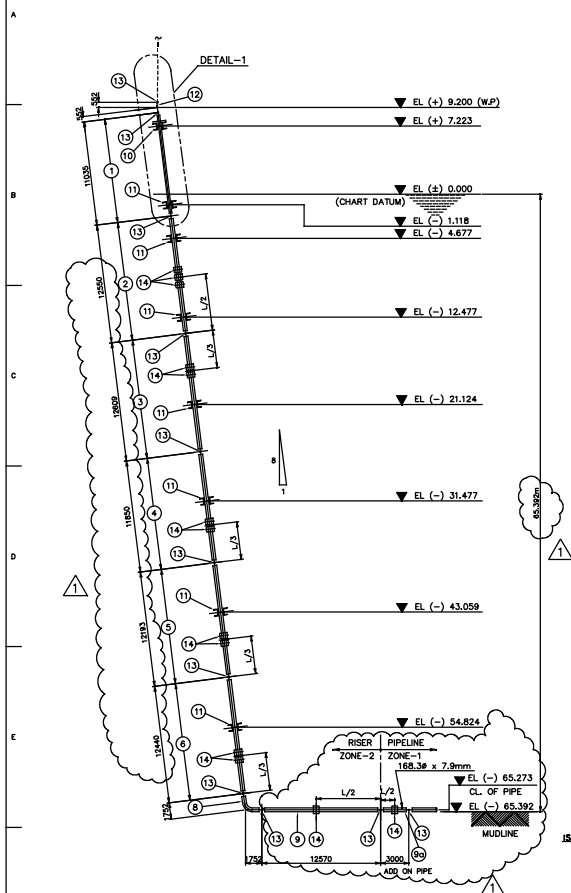

N10 PLATFORM
6 INCH W.I RISER ELEVATION

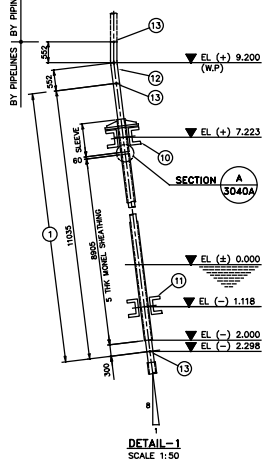

DETAIL-1
SCALE 1:50

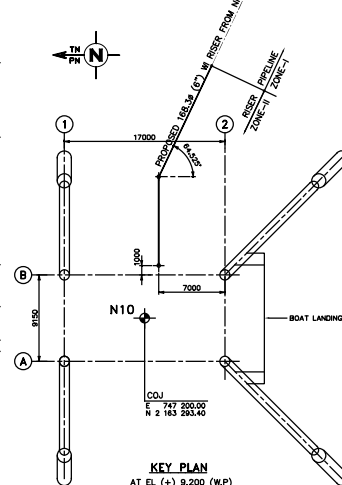

KEY PLAN
AT EL (+) 9.200 (W.P.)

SL. NO	DESCRIPTION	QUANTITY	APPROX. LENGTH (m)
1	168.36 x 14.3 WT RISER PIPE COMPLETE WITH MONEL CLADDING AND HANGER SUPPORT	1	11.035
2	168.36 x 14.3 WT RISER PIPE WITH 4.75mm CTE & 30mm CONCRETE COATING AND 3 CENTRAL ANODES	1	12.550
3	168.36 x 14.3 WT RISER PIPE WITH 4.75mm CTE & 30mm CONCRETE COATING AND 2 ECCENTRIC ANODES	1	12.809
4	168.36 x 14.3 WT RISER PIPE WITH 4.75mm CTE & 30mm CONCRETE COATING AND 2 ECCENTRIC ANODES	1	11.850
5	168.36 x 14.3 WT RISER PIPE WITH 4.75mm CTE & 30mm CONCRETE COATING AND 2 ECCENTRIC ANODES	1	12.193
6	168.36 x 14.3 WT RISER PIPE WITH 4.75mm CTE & 30mm CONCRETE COATING AND 2 ECCENTRIC ANODES	1	12.440
7	168.36 x 14.3 WT RISER LOWER BEND WITH 4.75mm CTE & 30mm CONCRETE COATING (BEND ANGLE 83.571)	1	—
8	168.36 x 14.3 WT RISER PIPE (ZONE-1) WITH 4.75mm CTE & 30mm CONCRETE COATING AND 1 CENTRAL ANODE	1	12.570
9	168.36 x 7.8 WT PIPELINE PIPE WITH 4.75mm CTE & 30mm CONCRETE COATING AND 1 CENTRAL ANODE	1	3.000
10	HANGER SUPPORT	1	—
11	RISER GUIDES	7	—
12	168.36 x 14.3 WT TRANSITION BEND (BEND ANGLE 7.125)	1	—
13	FIELD JOINT	1	—
14	ANODES (TYPE-III) (348MM LONG EACH 14.25 KG)	13	—

MATERIAL GRADE FOR RISER PIPES AND BENDS : API 5L Gr. X52, SEAMLESS

0102-1-1-3010

1. ALL DIMENSIONS ARE IN MILLIMETRES AND LEVELS ARE IN METRES U.M.A.L.
2. ALL LEVELS ARE RELATED TO CHART DATUM.

AS BUILT

LEGEND	
#	DIAMETER
WT	WALL THICKNESS
CTE	COAL TAR ENAMEL
mm	MILLIMETRE
TH	TRUE NORTH
COJ	CENTER OF JACKET
W.P.	WORKING POINT
O.D.	OUTSIDE DIAMETER
UND	UNLESS NOTED OTHERWISE
EL	ELEVATION
L	PIPE JOINT LENGTH
TP	TYPICAL
W	WATER INJECTION
PN	PLATFORM NORTH
THK	THICKNESS
NO.	NUMBER
Kg	KILOGRAM

REFERENCE DRAWINGS/DOCUMENTS	
S.No	DRG./DOC. No.
1	9302-54-1-1000
2	9302-54-1-2000
3	2001 & 2002A
4	9302-54-1-3000A
5	9302-54-1-3001
6	9302-54-1-4000
7	9302-54-1-4001
8	9302-54-1-2005
9	9302-54-1-101
10	9302-54-1-102
11	2005
12	2012
13	2013
14	2014
15	2015
16	2009 FS

1	AS BUILT	VST	RDP	KOR	08.02.05
2	APPROVED FOR CONSTRUCTION	SVV	PVG	SB	02.02.04
C2	RE-ISSUED FOR CLIENT'S COMMENTS	SVV	PVG	SB	22.06.03
C1	ISSUED FOR CLIENT'S COMMENTS	SVV	PVG	SB	07.08.02

ONGC (OW) ONGC (OD) L&T VALDEL
OIL & NATURAL GAS CORPORATION LTD.
ENGG. SECTION, E&C DIVISION
MRCB, MUMBAI


LARSEN & TOUBRO LIMITED
CCSP, MUMBAI


VAL DEL
Engineers & Constructors
(Formerly and Trade Name)
16, Poonawalla Road, Poonawalla - 400 005

TITLE : N-9 & N-10 WELL PLATFORMS PROJECT
N10 PLATFORM
6 INCH W.I RISER ASSEMBLY DRAWING

SCALE	DRAWING NUMBER	REV
1:200	9302-54-1-3010	1

THIS DRAWING MUST NOT BE USED FOR CONSTRUCTION UNTIL SPECIFICALLY CERTIFIED FOR THAT PURPOSE UNDER AN ISSUE.

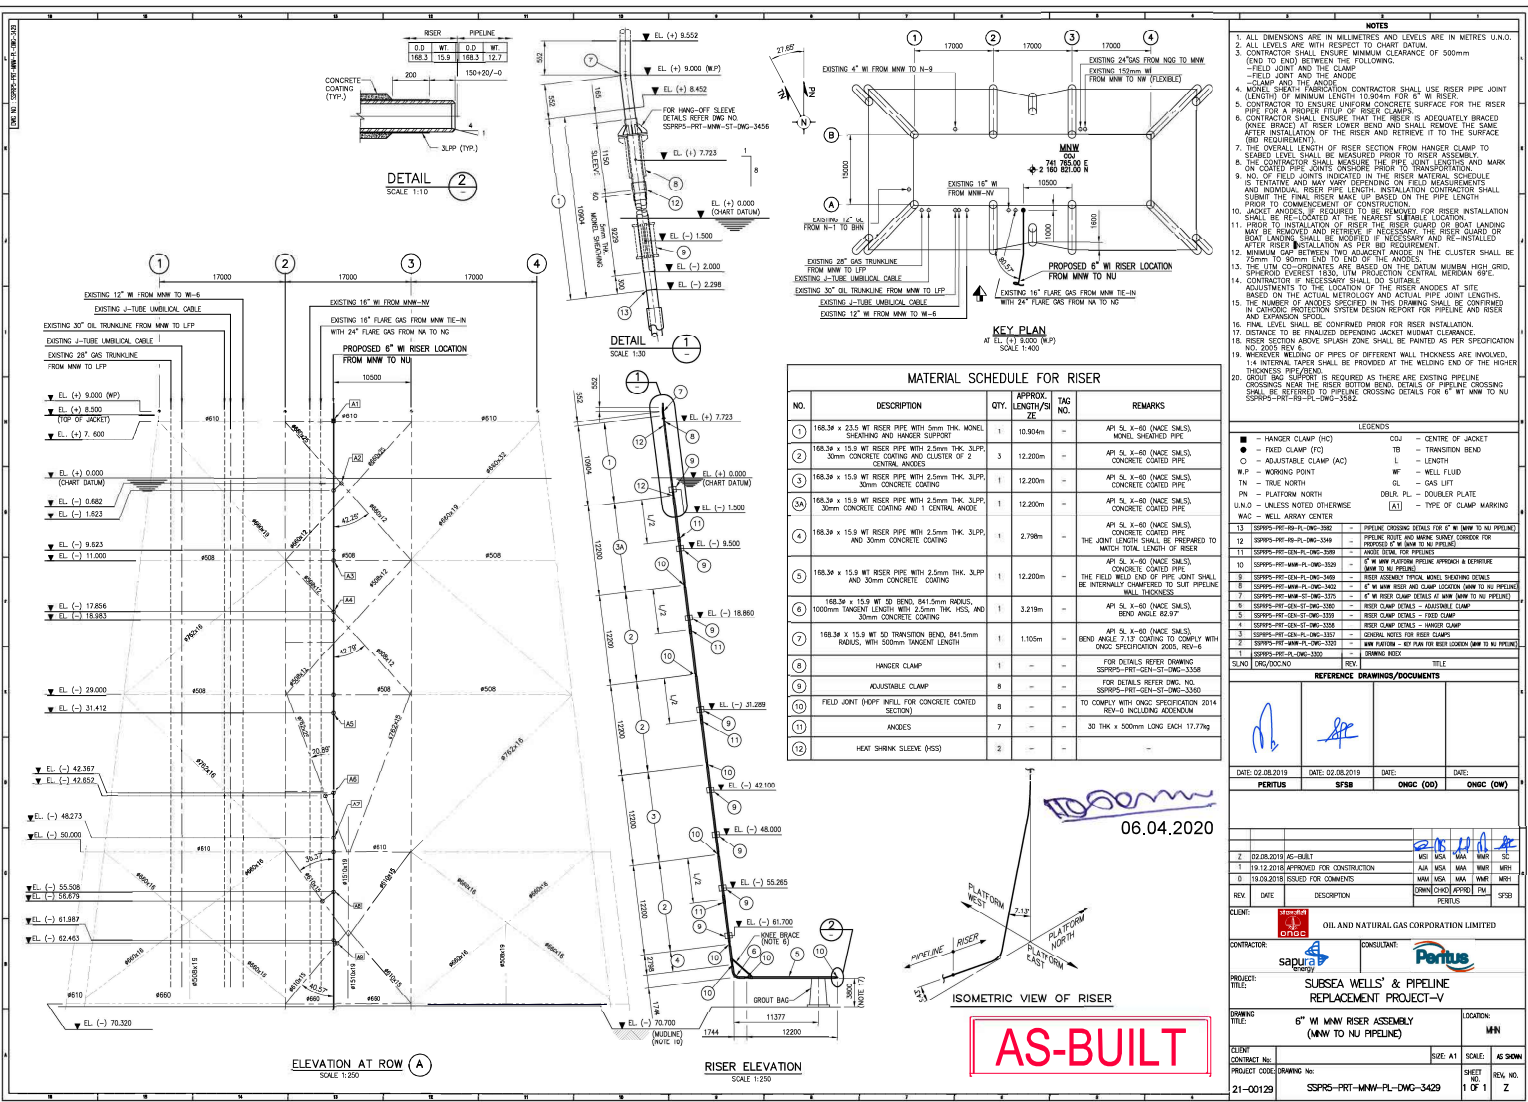

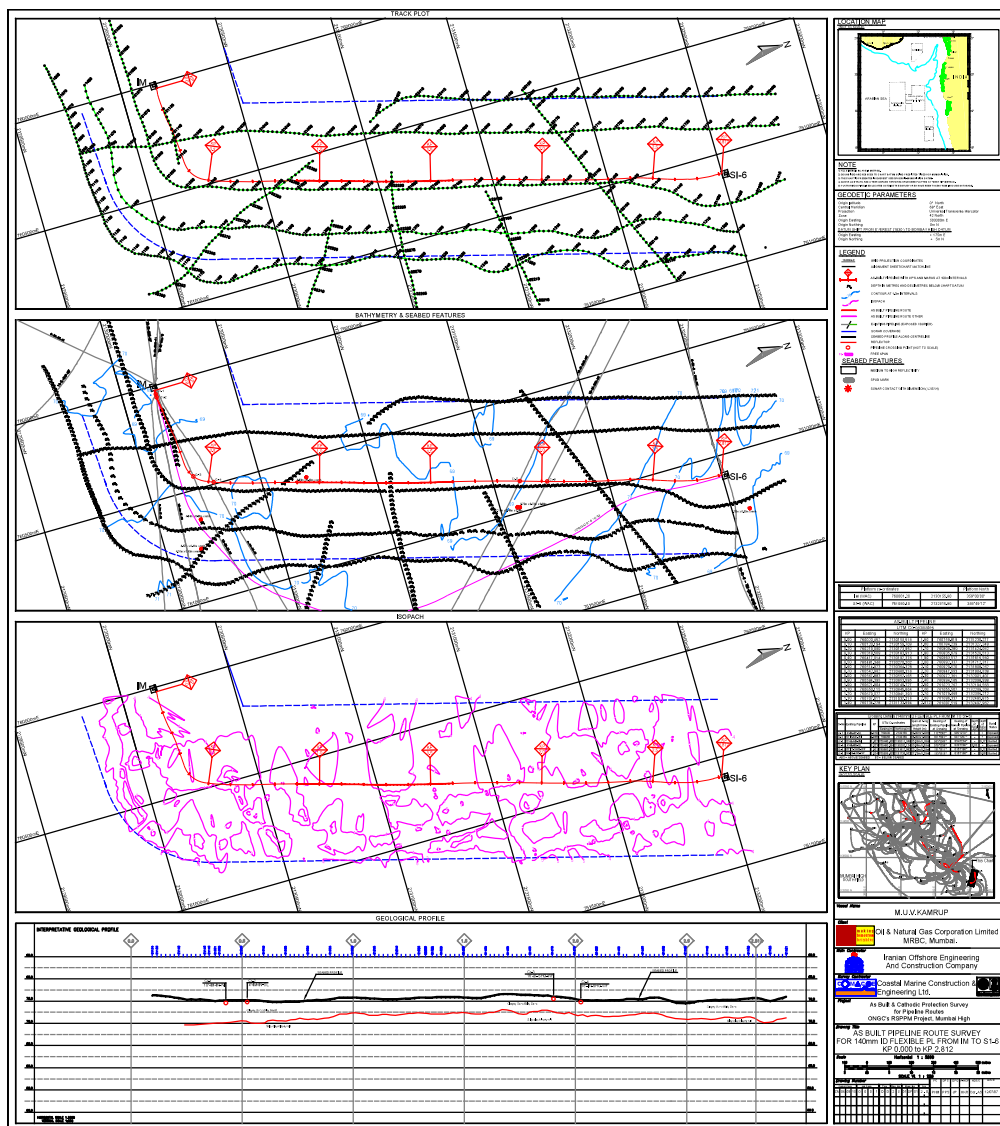


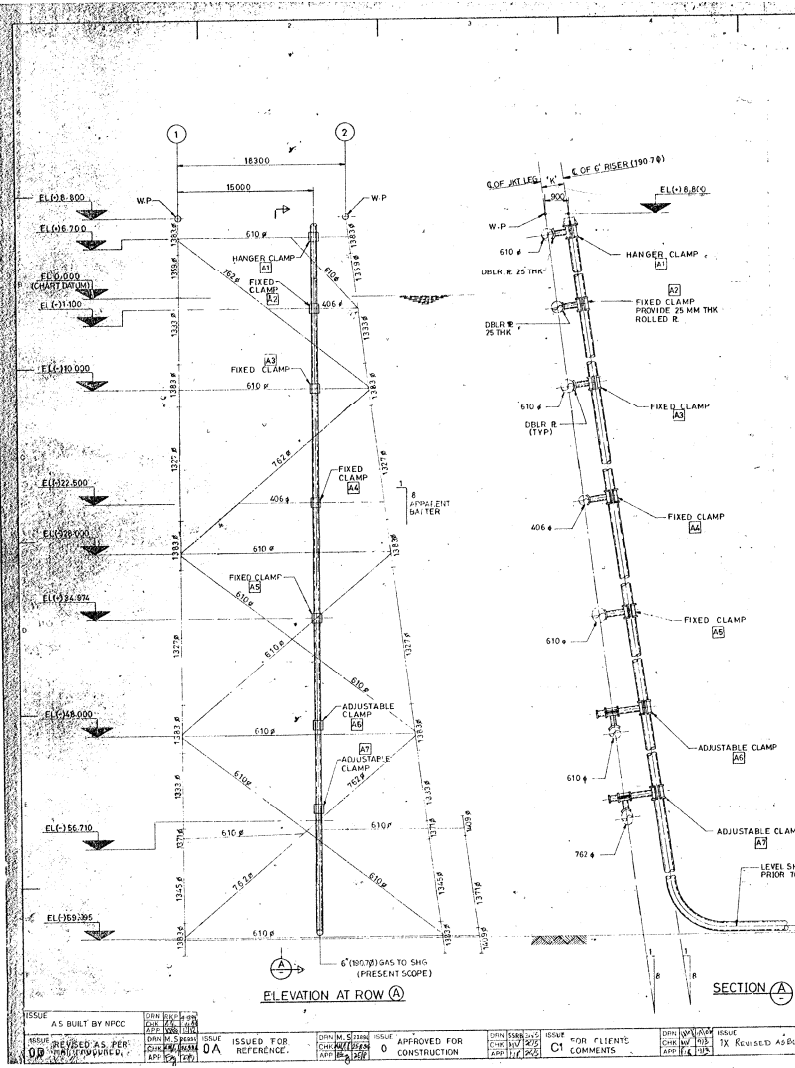


TABLE-1 6" (150.76) RISER

ELEVATION	MARK	TYPE	D	K	BOLT HOLE	SI	STRUT	BOLT HOLE	SI	STRUT
EL 136.700	A1	H C	253	CONST.	16	18	115	219 16x20.0	115	219 16x20.0
EL 139.100	A2	F C	248	"	"	"	219 16x20.0	"	"	"
EL 140.000	A3	F C	302	"	"	"	219 16x18.3	"	"	"
EL 142.500	A4	F C	302	"	"	"	"	"	"	"
EL 143.94	A5	F C	302	"	"	"	"	"	"	"
EL 148.000	A6	AC	302	"	"	"	16	18	115	273 16x12.7
EL 156.710	A7	AC	302	"	"	"	"	"	"	"

SHOP DRAWING
DATE: 26/05/2018
REVISED: 26/05/2018

APPROVED BY BUILT
DATE: 15/05/2018
BY: [Signature]

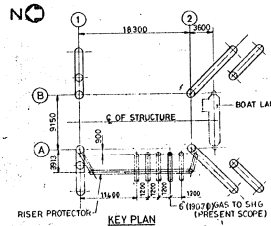

NOTE

- ALL DIMENSIONS ARE IN mm AND LEVELS ARE IN METRES UNO.
- RISER SHOWN IN FIRM LINE IS IN PRESENT SCOPE OF WORK.
- CLAMPS FOR FUTURE RISERS ARE NOT PROVIDED.
- ALL CLAMPS SHALL BE INSTALLED AT VARD TRUE TO THEIR ALIGNMENT & ORIENTATION CONFORMING TO APPROVED DRAWINGS ACCURATE CHECKS SHALL BE MADE TO DETECT ANY POSSIBLE MISALIGNMENT AND CORRECTIVE ACTION TO BE TAKEN BEFORE LOADOUT. CLAMPS SHALL BE KEPT IN CLOSED POSITION WITH ALL BOLTS LIGHTLY TIGHTENED.
- D IS THE INTERNAL DIA OF THE ROLLED PLATE
- FOR DIA 11, DIA 12, SI 52, BOLT HOLE, REFER RISER CLAMP DETAIL DRAWINGS
- RISER CLAMPS SHALL BE PAINTED AS PER SPEC GS-13

REFERENCE DRAWINGS

DRAWING NO	TITLE
9023.73.1.1401	JKT VERT FRMG ROW A & B
9023.73.1.1407A	RISER CLAMP DETAILS
9023.73.1.1408A	RISER CLAMP DETAILS

NPECC DRAWING NUMBER: 404-N-1031

INTER DISCIPLINE CHECK

PROCESS	MECHANICAL	ELECTRICAL	INSTRUMENTATION	STRUCTURAL CIVIL	PIPELINE
SUBMITTED TO	APPROVED BY	APPROVED BY	APPROVED BY	APPROVED BY	APPROVED BY
DATE	DATE	DATE	DATE	DATE	DATE

ISSUE: 01

JOHN BROWN

LARSEN & TOUBRO LIMITED

SI-SAND' PROJECT




RISER CLAMP LOCATION ON JACKET

SI-6 WELL PLATFORM

DRAWING NO: 9023.73.1.1417

ISSUE: 01

10182-S2-PL-ENG-DWG-21706
DRAWING NUMBER

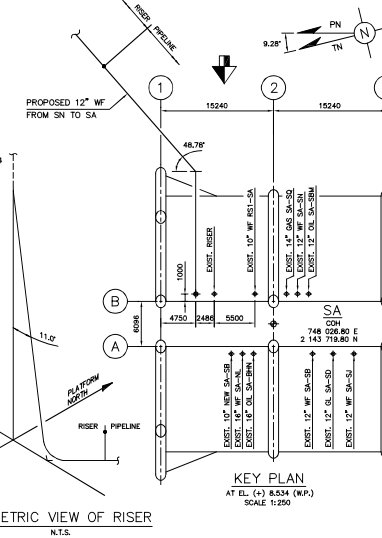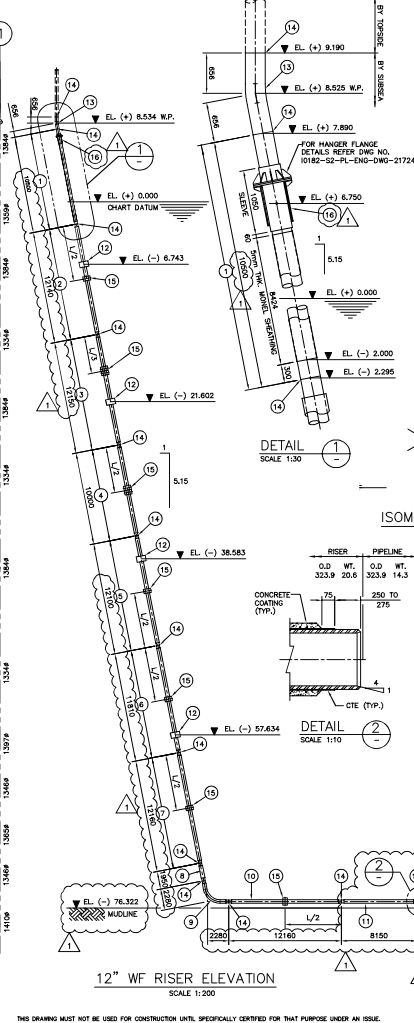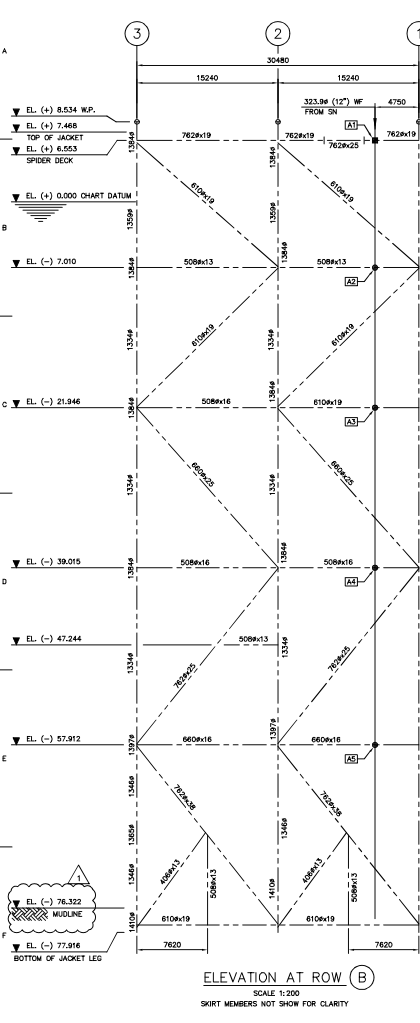

MATERIAL SCHEDULE FOR RISER				
NO.	DESCRIPTION	QTY. APPROX.	TAG NO.	REMARKS
1	323.90 x 23.8 WT RISER PIPE WITH 5mm THK. MONI. SHEATHING AND HANGER SUPPORT	1	10.500m	-
2	323.90 x 20.6 WT RISER PIPE WITH 4.75mm THK. CTE, 30mm CONCRETE COATING AND 1 CENTRAL ANODE	1	12.140m	-
3	323.90 x 20.6 WT RISER PIPE WITH 4.75mm THK. CTE, 30mm CONCRETE COATING AND 2 ECCENTRIC ANODES	1	12.150m	-
4	323.90 x 20.6 WT RISER PIPE WITH 4.75mm THK. CTE, 30mm CONCRETE COATING AND 2 CENTRAL ANODES	1	10.000m	-
5	323.90 x 20.6 WT RISER PIPE WITH 4.75mm THK. CTE, 30mm CONCRETE COATING AND 1 CENTRAL ANODE	1	12.100m	-
6	323.90 x 20.6 WT RISER PIPE WITH 4.75mm THK. CTE, 30mm CONCRETE COATING AND 1 CENTRAL ANODE	1	11.810m	-
7	323.90 x 20.6 WT RISER PIPE WITH 4.75mm THK. CTE, 30mm CONCRETE COATING AND 1 CENTRAL ANODE	1	12.160m	-
8	323.90 x 20.6 WT RISER PIPE WITH 4.75mm THK. CTE, 30mm CONCRETE COATING AND 1 CENTRAL ANODE	1	1.950m	-
9	323.90 x 20.6 WT 50 BEND, 1819.5mm RADIUS, 1000mm COUPLER LENGTH WITH 4.75mm THK. CTE, 30mm CONCRETE COATING AND 1 CENTRAL ANODE	1	1.580m	-
10	323.90 x 20.6 WT RISER PIPE (ZONE II) WITH 4.75mm THK. CTE, 30mm CONCRETE COATING AND 1 CENTRAL ANODE	1	12.160m	-
11	323.90 x 20.6 WT RISER PIPE WITH 4.75mm THK. CTE, 30mm CONCRETE COATING	1	8.150m	-
12	RISER GUIDES	4	-	-
13	323.90 x 23.8 WT 50 TRANSITION, BEND, 1819.5mm RADIUS, WITH 300mm COUPLER LENGTH	1	-	-
14	FIELD JOINT	1	-	-
15	ANODES (TYPE 52-45)	9	-	-
16	HANGER SUPPORT	1	-	-

NOTES

- ALL DIMENSIONS ARE IN MILLIMETRES AND LEVELS ARE IN METRES UNLESS OTHERWISE SPECIFIED.
- ALL LEVELS ARE WITH RESPECT TO CHART DATUM.
- INSTALLATION CONTRACTOR SHALL ENSURE THAT EDGE OF ALL ANODES AND FIELD JOINTS TO HAVE A MINIMUM CLEARANCE OF 500mm FROM THE EDGE OF CLAMP/JOINT.
- MONI. SHEATH FABRICATION CONTRACTOR SHALL USE RISER PIPE JOINT (LENGTH) OF MINIMUM LENGTH 10.75m FOR 12\"/>
- CONTRACTOR TO ENSURE UNIFORM CONCRETE SURFACE FOR THE RISER PIPE FOR A PROPER FIT-UP OF RISER CLAMPS.
- INSTALLATION CONTRACTOR SHALL ENSURE THAT THE RISER IS ADEQUATELY BRACED (KNEE BRACE) AT RISER LOWER END AND SHALL REMAIN THE SAME AFTER INSTALLATION OF THE RISER AND RETRIEVE IT TO THE SURFACE (BID REQUIREMENT).
- THE OVERALL LENGTH OF RISER SECTION FROM HANGER CLAMP TO SEALED LEVEL SHALL BE MEASURED PRIOR TO RISER ASSEMBLY.
- THE CONTRACTOR SHALL MEASURE THE PIPE JOINT LENGTHS AND MARK ON COATED PIPE JOINTS PRIOR TO TRANSPORTATION.
- NO. OF FIELD JOINTS INDICATED IN THE RISER MATERIAL SCHEDULE IS TENTATIVE AND MAY VARY DEPENDING ON FIELD MEASUREMENTS AND INDIVIDUAL RISER PIPE LENGTH. INSTALLATION CONTRACTOR SHALL SUBMIT THE FINAL RISER MAKE-UP BASED ON THE PIPE LENGTH PRIOR TO COMMENCEMENT OF CONSTRUCTION.
- JACKET ANODES, IF REQUIRED TO BE REMOVED FOR RISER INSTALLATION SHALL BE RE-LOCATED AT THE NEAREST SUITABLE LOCATION.
- PRIOR TO INSTALLATION OF RISER THE BOAT LANDING AND BARGE BUMPER SHALL BE REMOVED AND RETRIEVE IF NECESSARY. THE BOAT LANDING AND BARGE BUMPER SHALL BE MODIFIED, IF NECESSARY AND RE-INSTALLED AFTER RISER INSTALLATION AS PER BID REQUIREMENT.
- REFER TO DRAWING 10182-S2-PL-ENG-DWG-21703 FOR GROUT BAG SUPPORT DETAILS.

AS-BUILT

LEGEND

■	HANGER CLAMP (HC)	PN	PLATFORM NORTH
●	FIXED CLAMP (FC)	W	WATER INJECTION
○	ADJUSTABLE CLAMP (AC)	WF	WELL FLUID
W.P.	WORKING POINT	GL	GAS LIFT
TN	TRUE NORTH	COH	CENTER OF HOLE/LEG

REFERENCE DRAWINGS/DOCUMENTS

S.NO.	DWG./DOC. NO.	REV.	TITLE
1	10182-S2-PL-ENG-DWG-21702	-	DRAWING INDEX
2	10182-S2-PL-ENG-DWG-21703 & 21704	-	RISER CLAMP DETAILS
3	10182-S2-PL-ENG-DWG-21707	-	TYPICAL KNEE BRACE DETAIL FOR RISERS
4	10182-S2-PL-ENG-DWG-21708	-	RISER PIPE COATING SCHEDULE
5	10182-S2-PL-ENG-DWG-21709	-	PIPELINE ALIGNMENT 12\"/>
6	10182-S2-PL-ENG-DWG-21740	-	SA PLATFORM PIPELINE APPROACH AND DEPARTURE
7	10182-S2-PL-ENG-DWG-21759	-	SA PLATFORM - LOCATION OF 12\"/>
8	10182-S2-PL-ENG-DWG-21774	-	SA PLATFORM - 12\"/>
9	10182-S2-PL-ENG-DWG-21783	-	12\"/>

OWNER : OIL & NATURAL GAS CORPORATION LTD. ONGC SECTION, EAC DIVISION

CONSULTANT : INTECSEA


CONTRACTOR : LEIGHTON CONTRACTORS INDIA PVT. LTD.

PROJECT : PIPELINE REPLACEMENT PROJECT-2

TITLE : SA PLATFORM 12\"/>

SCALE	DRAWING NUMBER	REV.
AS SHOWN	10182-S2-PL-ENG-DWG-21706	1

THIS DRAWING MUST NOT BE USED FOR CONSTRUCTION UNLESS SPECIFICALLY CERTIFIED FOR THAT PURPOSE UNDER AN ISSUE.

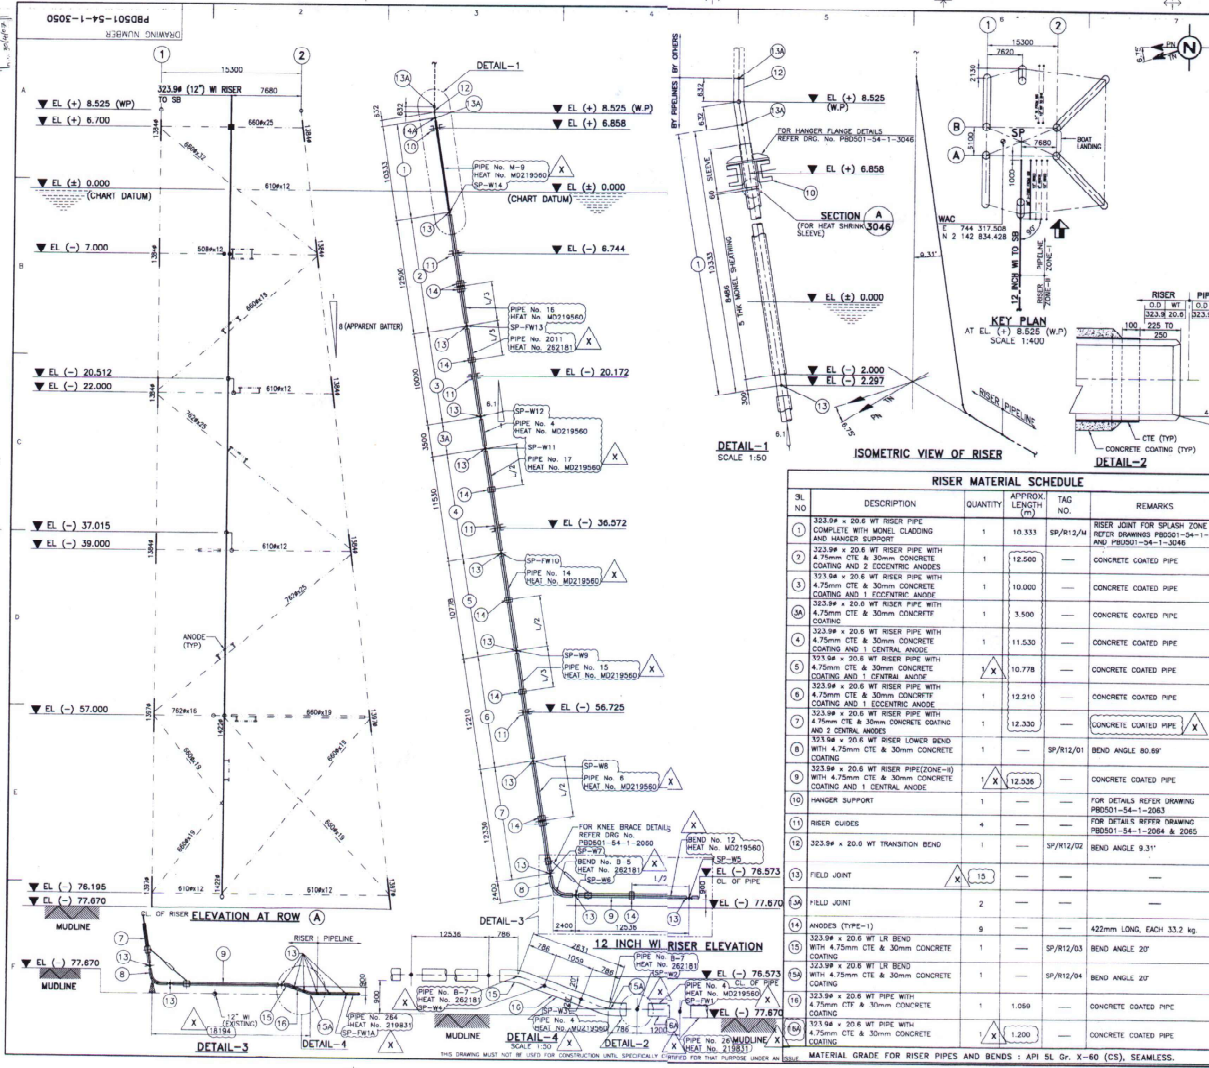

100

RISER MATERIAL SCHEDULE					
S.L. NO	DESCRIPTION	QUANTITY	APPROX. LENGTH (m)	TAG NO.	REMARKS
1	323.84 x 20.6 WT RISER PIPE COMPLETE WITH MONEL CLADDING AND HANGER SUPPORT	1	10.333	SP/R12/01	RISER JOINT FOR SPLASH ZONE REFER DRAWING PB0501-54-1-3045 AND PB0501-54-1-3046
2	323.84 x 20.6 WT RISER PIPE WITH 4.75mm CTE & 30mm CONCRETE COATING AND 2 ECCENTRIC ANODES	1	12.500	---	CONCRETE COATED PIPE
3	323.84 x 20.6 WT RISER PIPE WITH 4.75mm CTE & 30mm CONCRETE COATING AND 1 ECCENTRIC ANODE	1	10.000	---	CONCRETE COATED PIPE
4	323.84 x 20.6 WT RISER PIPE WITH 4.75mm CTE & 30mm CONCRETE COATING AND 1 CENTRAL ANODE	1	3.500	---	CONCRETE COATED PIPE
5	323.84 x 20.6 WT RISER PIPE WITH 4.75mm CTE & 30mm CONCRETE COATING AND 1 CENTRAL ANODE	1	11.530	---	CONCRETE COATED PIPE
6	323.84 x 20.6 WT RISER PIPE WITH 4.75mm CTE & 30mm CONCRETE COATING AND 1 CENTRAL ANODE	1	10.778	---	CONCRETE COATED PIPE
7	323.84 x 20.6 WT RISER PIPE WITH 4.75mm CTE & 30mm CONCRETE COATING AND 1 ECCENTRIC ANODE	1	12.315	---	CONCRETE COATED PIPE
8	323.84 x 20.6 WT RISER PIPE WITH 4.75mm CTE & 30mm CONCRETE COATING AND 1 CENTRAL ANODE	1	12.330	---	CONCRETE COATED PIPE
9	323.84 x 20.6 WT RISER PIPE WITH 4.75mm CTE & 30mm CONCRETE COATING AND 1 CENTRAL ANODE	1	12.536	---	CONCRETE COATED PIPE
10	HANGER SUPPORT	1	---	---	---
11	RISER CLAMP	4	---	---	FOR DETAILS REFER DRAWING PB0501-54-1-2080 & 2081
12	323.84 x 20.6 WT TRANSITION BEND	1	---	SP/R12/02	BEND ANGLE 9.31°
13	FIELD JOINT	2	---	---	---
14	ANODES (TYPE-1)	9	---	---	422mm LONG, EACH 33.2 kg
15	323.84 x 20.6 WT LR BEND WITH 4.75mm CTE & 30mm CONCRETE COATING	1	---	SP/R12/03	BEND ANGLE 20°
16	323.84 x 20.6 WT LR BEND WITH 4.75mm CTE & 30mm CONCRETE COATING	1	---	SP/R12/04	BEND ANGLE 20°
17	323.84 x 20.6 WT PIPE WITH 4.75mm CTE & 30mm CONCRETE COATING	1	1.069	---	CONCRETE COATED PIPE
18	323.84 x 20.6 WT PIPE WITH 4.75mm CTE & 30mm CONCRETE COATING	1	1.200	---	CONCRETE COATED PIPE

MATERIAL GRADE FOR RISER PIPES AND BENDS: API 5L Gr. X-60 (CS), SEAMLESS.